

WATER SERVICE RECORD

Name A.F. Stucke

Service No. #20

Address 31 Hancock Street

Location

~~RENEWAL~~ New Service WO #7101


Com on 4-25-62

Date	Material	Amount	Total	Date	Amount
4-6-62	Labor	32.99		4-2-62	Deposit 150.00
4-20-62	Labor	11.13	44.12	4-25-62	Returned 51.35
	10% O.H.	4.41	48.53		98.65
	60' 3/4" Copper tubing @.42		25.20		
	1 3/4" Cx 1/2 I.W.H. Stop & Waste		6.17		Non-Charge
	2 Hrs. Trucking @3.00		6.00	4-6-62	Labor 6.29
	1 Hr. Loader @3.00		3.00		
	1 1/2 Hrs. Town Shovel @6.50		9.75	17'	3/4" Copper tubing @.42 7.14
			98.65	1	3/4" C Corp Cock 4.91
				1	3/4" C Curb Cock 6.28
				1	Box & Rod 4.90
				1	1/2 Straight Tailpiece .50
				1	1/2 Offset Tailpiece .50
				1/2	Hr. Town Shovel @6.50 3.25
				1	Hr. Trucking @3.00 3.00
				17	X 3 Patch 17.00
					53.77

DATE \_\_\_\_\_

TOWN OF LEXINGTON — BOARD OF PUBLIC WORKS  
WATER DIVISION

Sketch of Service Here

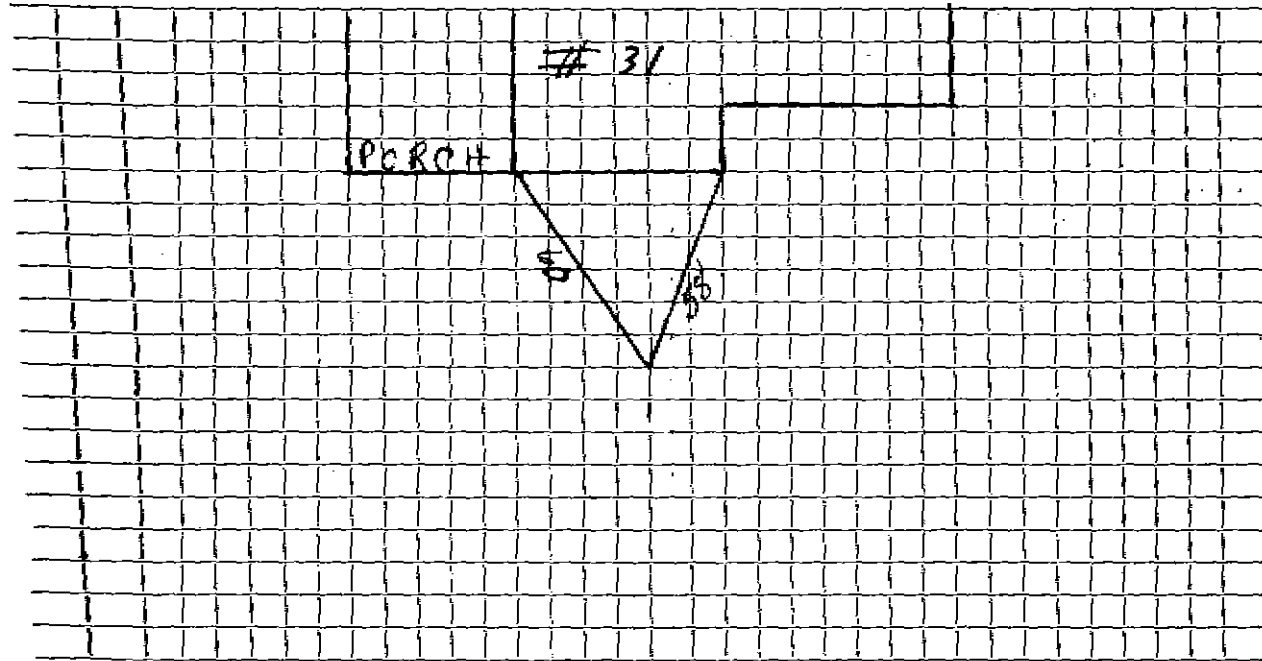

Connection made in Edgewood Road Street. Work completed .....

Remarks: .....  
.....  
.....