

WATER SERVICE RECORD

Name William T. Spencer

Service No. 17

Address 32 Hancock Street

#5740

Location

~~Repair~~ - ~~Renewal~~ - ~~New Service~~

W.O. #0500


AUG 6 1979

Date	Material	Amount	Total	Date	Amount	
6/11/79	Labor	42.34		6/12/79	Deposit	150.00
	10% O.H.	4.23	46.57	8-6-79	Renewal	40.50
	33' 1" Copper @ .90		29.70			165.46
	1 1" Stop & Waste		17.85		OUTSIDE W.O. #0499	
	1 1" X 3/4" Reducer		1.84	6/12/79	Labor	
	1 Hr. Trucking		3.00		7' 1" Copper	
	1 Hr. Backhoe		6.50		1 1" Curb	
			105.46		Hot Top 5' X 4' Sidewalk	
					2 3/4 Hrs. Trucking	
					1/4 Hr. Roller	
					2 Hrs. Case	

DATE _____

TOWN OF LEXINGTON — BOARD OF PUBLIC WORKS
WATER DIVISION

Sketch of Service Here

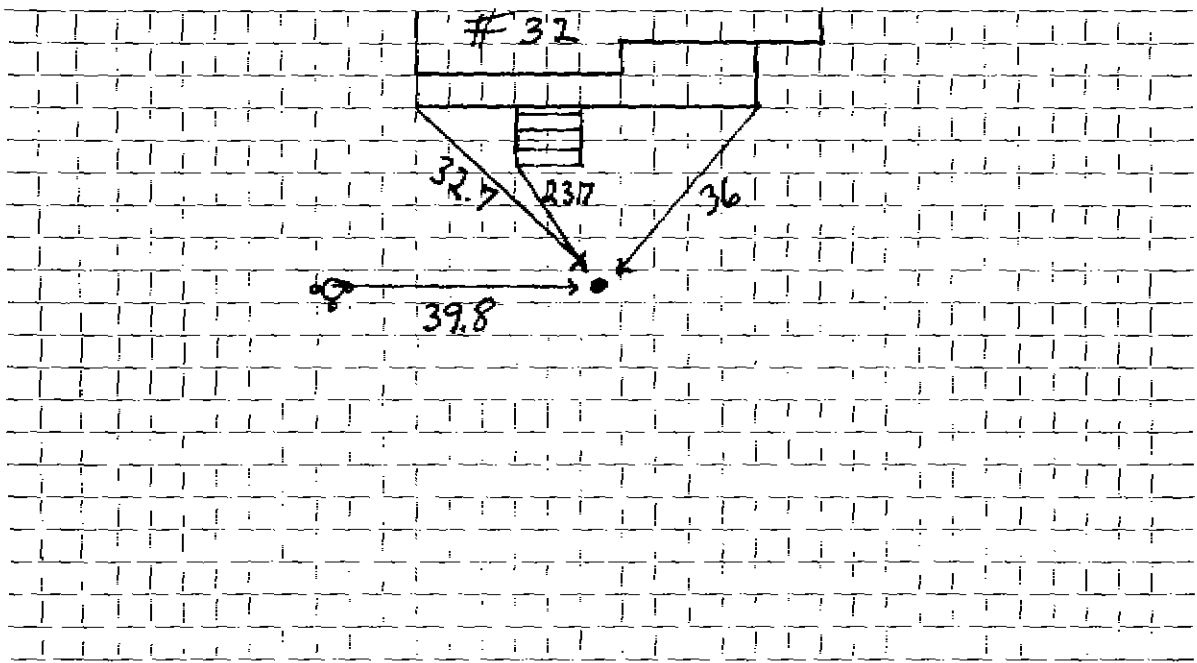

Connection made in Street. Work completed

Remarks:
.....
.....