

Name Carl Erickson  
 Address 33 Hancock Street  
 Lexington, Mass.

Service No. 1145

112959

Kind of Pipe                      Size                      Size of Main  
 Location

Repair—Renewal—New Service

Date	Material	Amount	Total	Date	Location	Amount
Oct. 11, '48	Labor	25 00	25 00	Oct 6 '48	Disputed	60 00
	10% Overhead		2 50	Dec 31 '48	Disputed	10 00
	66' -3/4" Copper Tubing @ .255	16 83			Non-charge	49 55
	1-3/4" C x 1/2" I.W.H. S&W	3 15		Oct. 12, '48	Labor	32 34
	1-3/4" C x 3/4" C. Union (3 pts)	1 32			28' -3/4" Copper Tubing @ .255	4 96
	1 hr. Trucking		75		1-3/4" C. Corp-cock	3 00
			49 55		1-3/4" C x 3/4" C. Curb-cock	3 68
					1-Box & Rod	3 55
					2 hrs. Littlefield Shovel	14 00
					1 hr. Hough Loader	3 00
					1-1/2" Offset Tail Piece	30
					1-1/2" Straight Tail Piece	30
					1 hr. Trucking	75
					Patching 25 x 3	25 00
						90 88

DATE \_\_\_\_\_

# TOWN OF LEXINGTON—BOARD OF PUBLIC WORKS

## WATER DIVISION

The undersigned applies for a supply of water at No. \_\_\_\_\_ St. and hereby agrees to comply with the rules and regulations as now, or at any future time, established by the Board of Selectmen.

Am't. of Estimate \$ \_\_\_\_\_


Owner \_\_\_\_\_

Am't. Paid \$ \_\_\_\_\_

Address \_\_\_\_\_

Builder \_\_\_\_\_

Sketch of Service Here

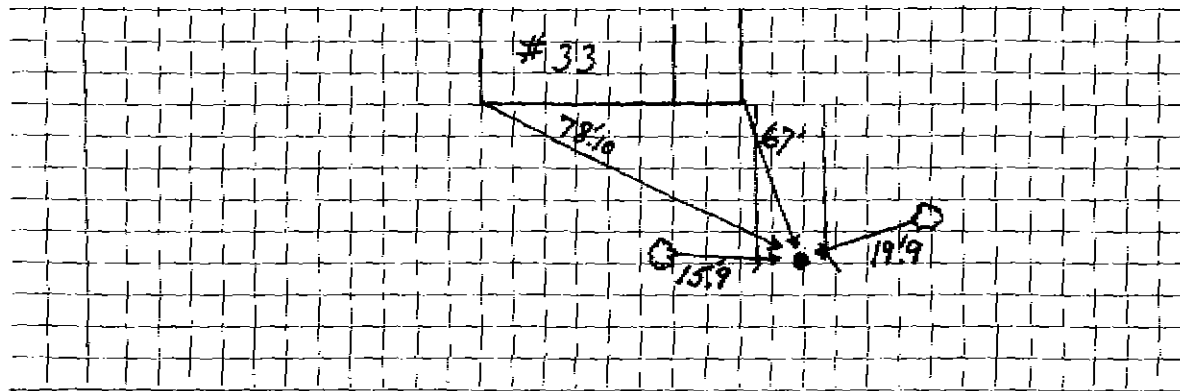

Connection made in \_\_\_\_\_ Street.

Work completed \_\_\_\_\_ 19

Remarks: