

Name William Swift  
 Address 34 Hancock Street  
 Lexington, Mass.

Service No. ~~27~~ 1146

Location 34 Hancock Street

Kind of Pipe

Size

Size of Main

~~Repair—Renewal—New Service~~

Location

Date	Material	Amount	Total	Date	Location	Amount
Oct. 27, '45	Labor	31 05	31 05	Oct 26 '45	Deposited	68 00
	10% Overhead		3 11	Nov. 21 '45	Refunded	<del>21 91</del>
	43' - $\frac{3}{4}$ " Copper Tubing		8 22		Main - Curb	46 01
	1 - $\frac{3}{4}$ " C x $\frac{3}{4}$ " C. W.H. Stop & Was	2 59		10-27-45	Labor	4 10
	1 - $\frac{3}{4}$ " x $\frac{1}{2}$ " Bushing		29		5' - $\frac{3}{4}$ " Copper Tubing	96
	Trucking 1 hr. @ .75		<u>75</u>		1- $\frac{3}{4}$ " C x $\frac{3}{4}$ " C. Curbcock	3 02
			46 01		1- 5/8" Copper Adapter	1 18
					1 Box & Rod	1 65
					Trucking 1 hr. @ .75	75
					Patching 5 x 3	<u>3 32</u>
						14 98
	Labor					

DATE \_\_\_\_\_

# TOWN OF LEXINGTON—BOARD OF PUBLIC WORKS

## WATER DIVISION

The undersigned applies for a supply of water at No. \_\_\_\_\_ St. and hereby agrees to comply with the rules and regulations as now, or at any future time, established by the Board of Selectmen.

Am't. of Estimate \$ \_\_\_\_\_


Owner \_\_\_\_\_

Am't. Paid \$ \_\_\_\_\_

Address \_\_\_\_\_

Builder \_\_\_\_\_

Sketch of Service Here

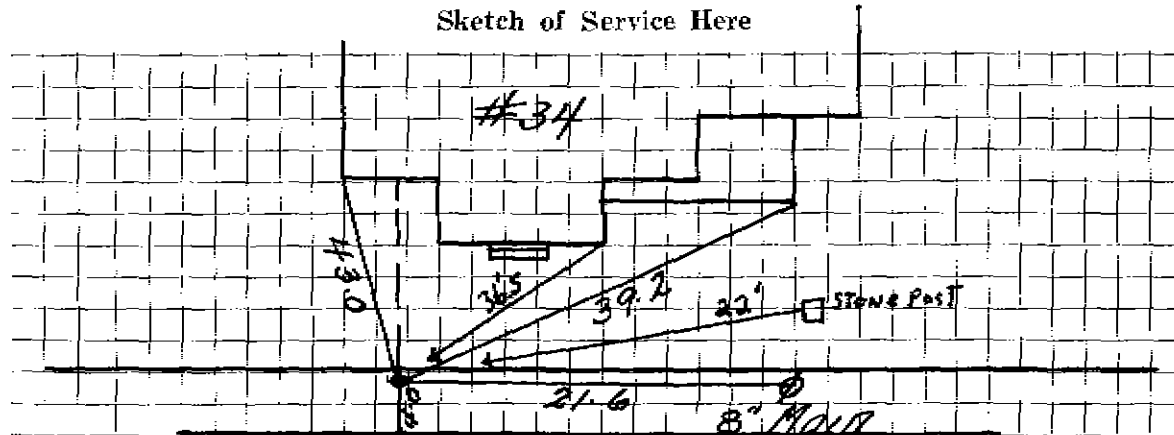

Connection made in Hancock Street. St. Work completed \_\_\_\_\_ 19

Remarks: