

WATER SERVICE RECORD

Name HANCOCK-CLARKE House

Service No.

Address

Location 36 HANCOCK ST

Repair—Renewal—New Service

Date	Material	Amount	Total	Date	Amount
------	----------	--------	-------	------	--------

COPPER

COPPER

CORP

CURB


Box + Rod

DATE _____

TOWN OF LEXINGTON — BOARD OF PUBLIC WORKS

WATER DIVISION

Sketch of Service Here

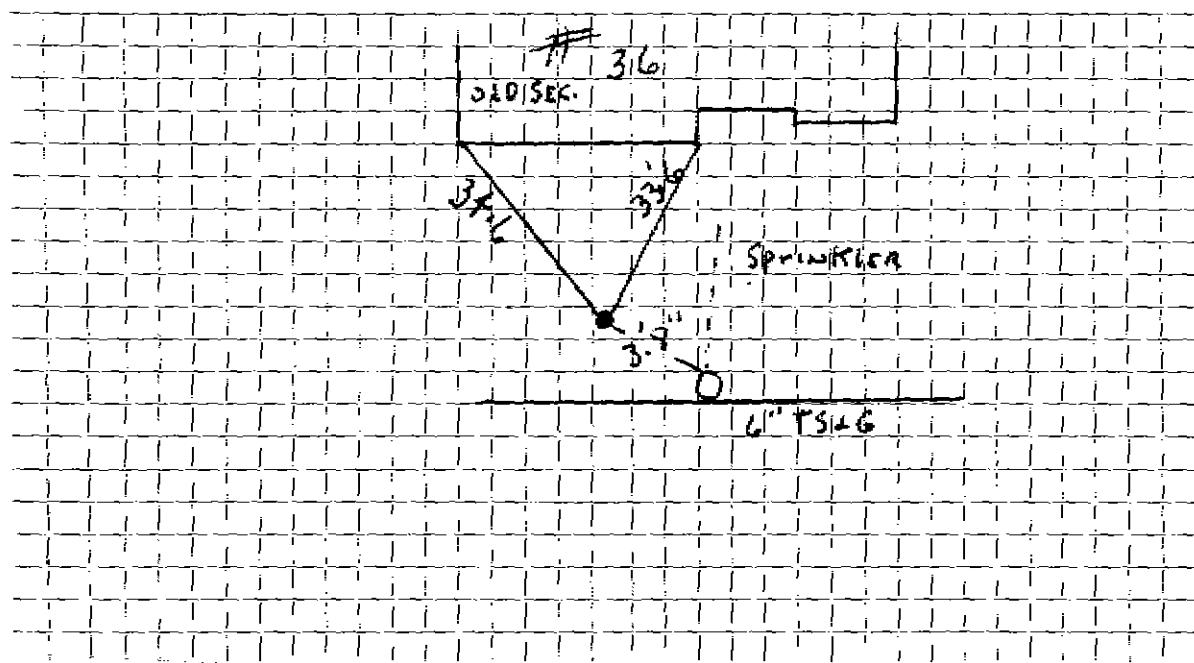

Connection made in Street. Work completed

Remarks: