

WATER SERVICE RECORD

Name Richard L. Wright

Service No. 105

Address 37 Hancock Street

#9057

Location

~~Repair~~ - Renewal - ~~Non Service~~

000. 7-19-54


Date	Material	Amount	Total	Date	Amount
5/26/54	Labor	37 63		5-12-54 Deposited	75 00
	10% overhead	3 76	41 39	7-20-54 Refunded	6 11
	65' - 3/4" copper tubing @ .35		22 75		<u>NON CHARGE</u>
	1 - 3/4" C x 1/8 I.W.H. stop & waste	4 00		5/26/54 Labor	20 00
	1 hr. trucking		75	1 - 1/8 offset tail piece	50
			68 89	1 - 1/8 straight tail piece	50
					<u>21 00</u>
				OUTSIDE W.O. #0512	
				6/14/19/18/79 Labor	
				35' 3/4" Copper	
				1 3/4" Curb	
				1 3/4" Adapter	
				1 Box & Rod	
				4 1/2 Hrs. Trucking	
				3 Hrs. Case	

DATE _____

TOWN OF LEXINGTON — BOARD OF PUBLIC WORKS

WATER DIVISION

Sketch of Service Here

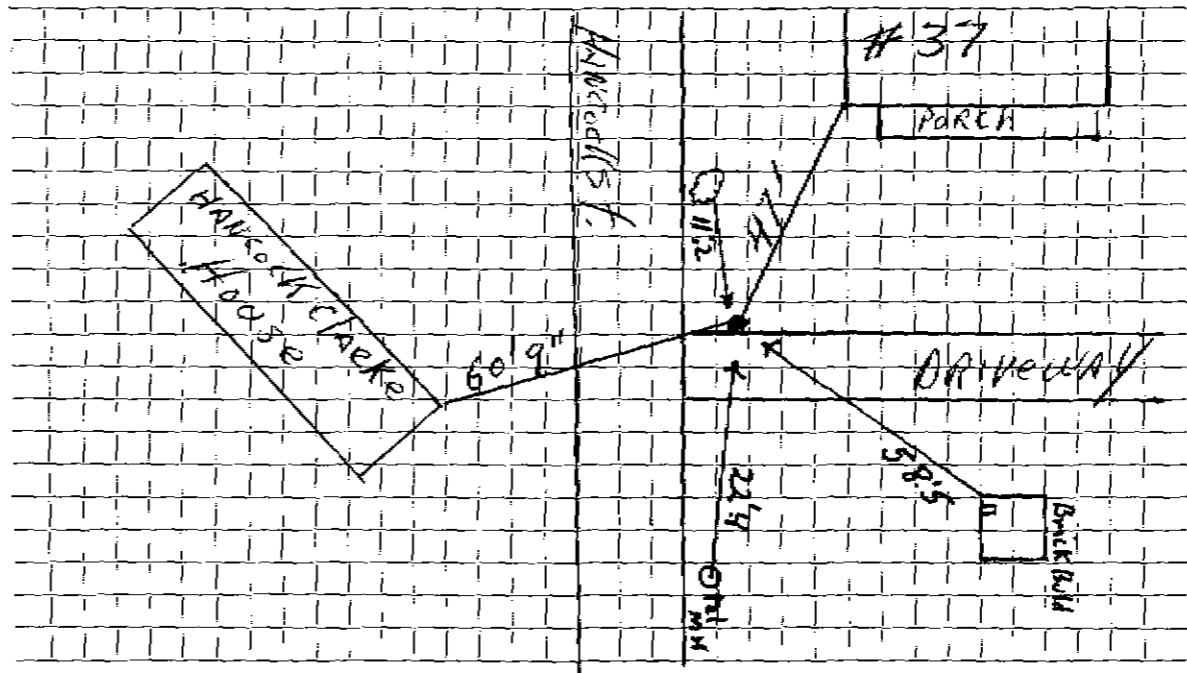

Connection made in Street. Work completed

Remarks:
.....
.....