

Name William L. Jackson
 Address 40 Hancock Street

Service No. ~~4~~ 1150

Location Same

Kind of Pipe

Size

Size of Main

~~Repair-Renewal~~ New Service

Location

Date	Material	Amount	Total	Date	Amount
10/4/34	53 1" C. Pipe @ .20	10 60			
11-27-34 Comm. 07 to Russell	1 S S W	2 75			
	Tracking	75	14 10		
	34 Hrs. Labor @ .55	35 20			
	24 " " @ .50	12 00			
	1 " " @ .60	60	47 80		
	10% Overhead		4 78		
	<u>COST</u>		66 68		
<u>CHARGE</u>	63 1 01.00 = \$88.00, but as cost exceeded labor's deposit, say		57 00	Oct. 3 1934 - Cash	57 -

Bradley Press, Inc., Lexington

DATE October 9, 1934

TOWN OF LEXINGTON—BOARD OF PUBLIC WORKS
WATER DIVISION

The undersigned applies for a supply of water at No. 40 Hancock St. and hereby agrees to comply with the rules and regulations as now, or at any future time, established by the Board of Selectmen.


Am't. of Estimate \$ 57

Owner William J. [Signature]

Am't. Paid \$ 57

Address _____

Builder _____

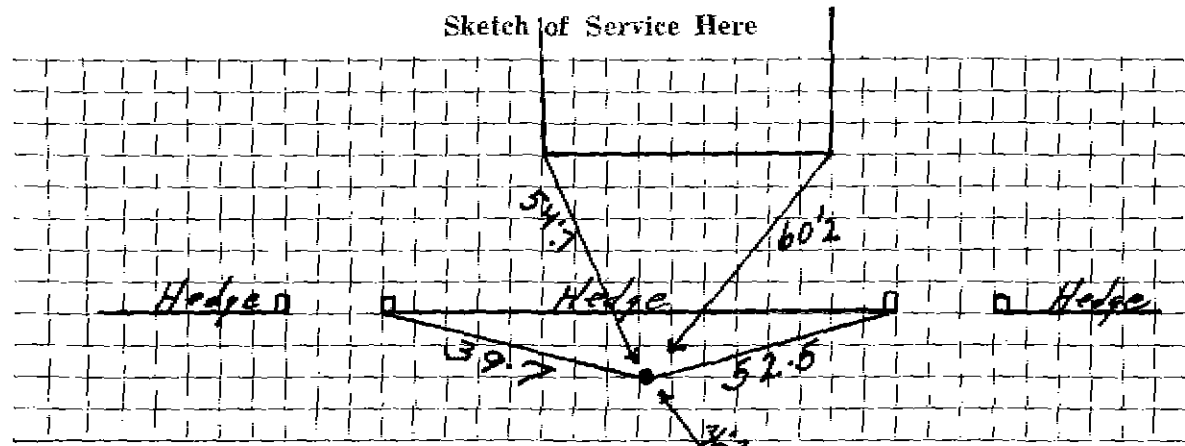

Connection made in _____ Street. Work completed _____ 19

Remarks: