

#1665

WATER SERVICE RECORD

Name Robert E. Hewes

Service No. 219

Address 43 Hancock Street

Location

Comm. 11-19-56

~~Repair~~ - New Service

Date	Material	Amount	Total	Date	Amount
8/13/56	Labor	15 02		7-23-56	Deposit 75 00
	10% overhead	1 50	16 52	2-11-57	Paid 7 45
	70' - 3/4" Copper tubing @ .4850	33 95			NON CHARGE # 82 45
	1 - 3/4" Cx 1/2 I.W.H. Stop & Waste	4 96		Labor	21 24
	1 - 3/4" Union (3 part)		2 27	26' - 3/4" coppertubing @ .4850	12 61
	1 hr. trucking		75	1 - 3/4" C. Corp Cock	4 64
	24x3 patch		24 00	1 - 3/4" C. Curb Cock	5 94
			82 45	1 box & rod	4 62
				1 - 1/2 Straight tailpiece	50
				1 - 1/2 Offset tailpiece	50
				1 hr. Littlefield Shovel	8 50
				1 hr. trucking	75
					59 30


Bill sent 11-21-56

DATE _____

TOWN OF LEXINGTON — BOARD OF PUBLIC WORKS

WATER DIVISION

Sketch of Service Here

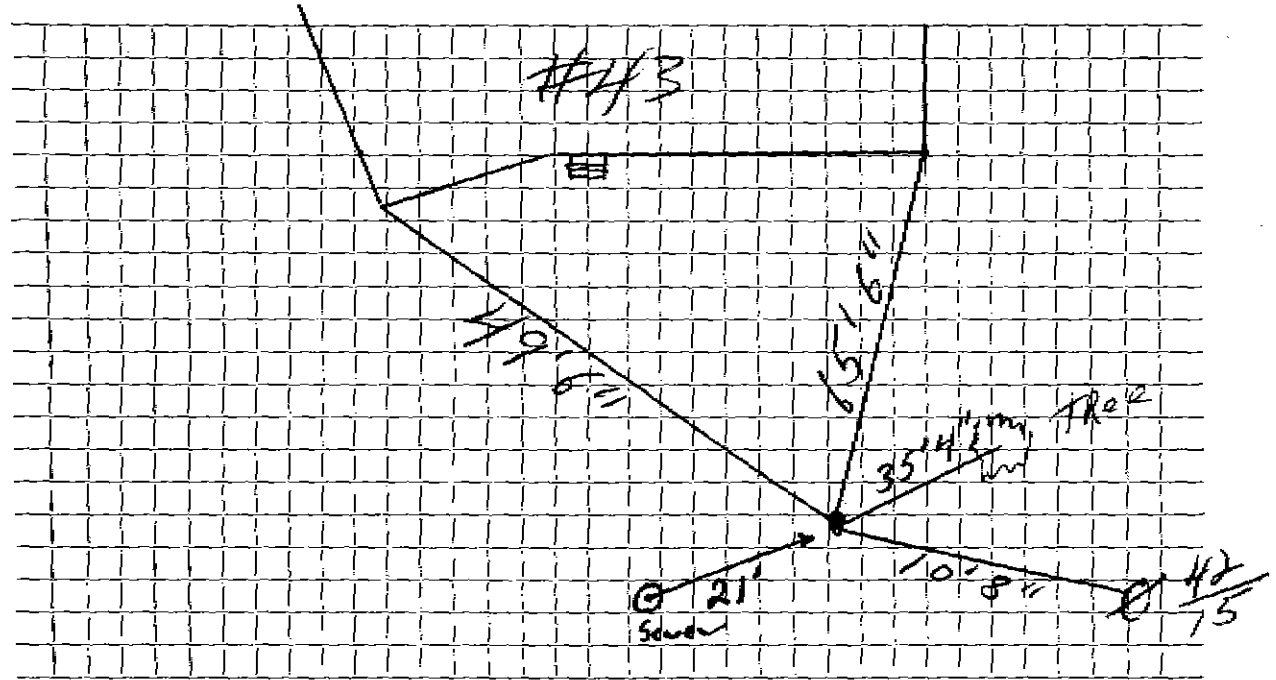

Connection made in Street. Work completed

Remarks:
.....
.....