

WATER SERVICE RECORD

Name *J. G. Homes Builders*

Service No. *8*

Address *45 Hancock Street*

Location

~~Repair/Replacement~~ *New Service* W.O. #1145 *Eagle #3616*

NOV 24 1980


Date	Material	Amount	Total	Date	Amount	
<i>12/18/80</i>	<i>39½' 1" Copper tubing</i>			<i>11-380</i>	<i>Deposit</i>	<i>230.85</i>
	<i>1 1" Stop &amp; Waste</i>					
	<i>1 1" Union</i>					
					<i>OUTSIDE W.O. #1145</i>	
				<i>5/12/80</i>	<i>Labor</i>	<i>104.39</i>
					<i>29' 1" Copper tubing @.90</i>	<i>26.10</i>
					<i>2' 1" Copper tubing @.90</i>	<i>1.80</i>
					<i>1 1" Corp.</i>	<i>22.04</i>
					<i>1 1" Curb</i>	<i>28.72</i>
					<i>1 Box &amp; Rod</i>	<i>17.80</i>
					<i>1 hr. Trucking</i>	<i>6.00</i>
					<i>2 hrs. Town Shovel @12.00</i>	<i>24.00</i>
					<i>To be billed when connected</i>	<i>230.85</i>

DATE \_\_\_\_\_

TOWN OF LEXINGTON — BOARD OF PUBLIC WORKS

**WATER DIVISION**

Sketch of Service Here

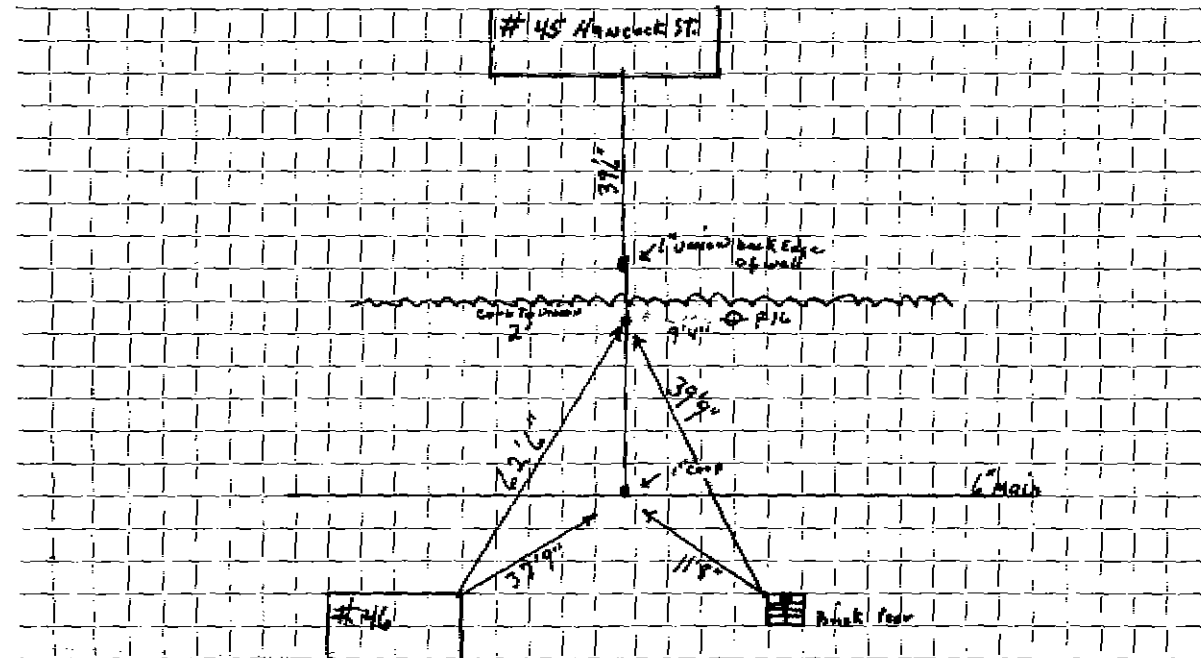

Connection made in ..... Street. Work completed .....

Remarks: .....

.....  
.....