

WATER SERVICE RECORD

Name Malcom

Service No. 15

Address 47 Hancock Street

Location

Repair—Renewal—New Service W.O. #0509

Comm 9-12-79


Date	Material	Amount	Total	Date	Amount
6/13/79	Labor	53.04		6-14-79	500.00
8/23/79	"	39.76			
	10% O.H.		92.20	7-10-79	221.03
8-23-79	78' 1" Copper Tubing @.90		70.20		278.97
	1 1" Union		8.31		
	1 1" Stop & waste		17.85	6/18/19/21/79	Labor
	1 1" x 3/4" Bureau Bush		1.84	12'	1" Copper
	1 3/4" Bush		1.56	1	1" Curb
	6 yds. Loan @ 5.44		32.64	1	1" Corp
	10 lbs. Seed @.74		7.40	1	Box & Rod
	1/2 bag. Fertilizer @ 4.00		2.00	4	Hrs. Trucking
	1/2 bag Lime @ 1.00		.50		Patch Street 20 X 6
	2 hrs. Trucking @3.00		6.00		Patch Driveway 5' X 10'
	4 1/2 hrs. Town Shovel @6.50		29.25	4	Hrs. Case
			278.97	1/2	Hr. Loader
				1	Hr. Roller

DATE \_\_\_\_\_

TOWN OF LEXINGTON — BOARD OF PUBLIC WORKS

WATER DIVISION

Sketch of Service Here

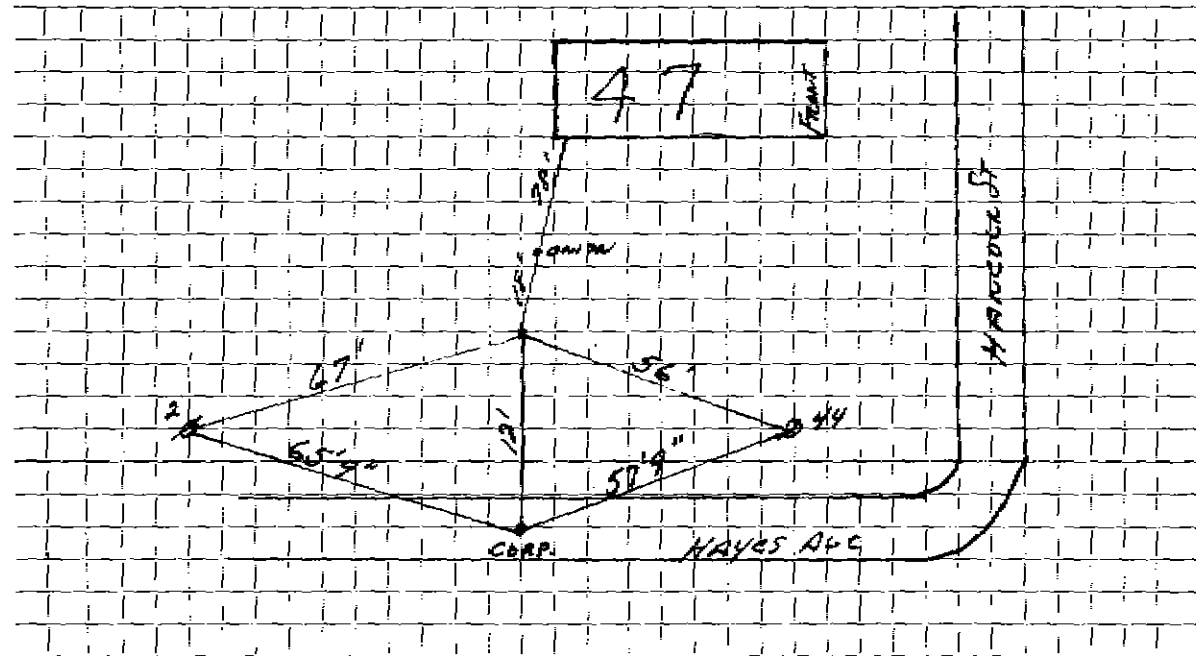

Connection made in ..... Street. Work completed .....

Remarks: *TAP ON HAYES AVE.* .....

.....  
.....