

Name Lester L. Downing

Service No. 818

Address 48 Hancock Street

Lexington, Mass.

Location 48 Hancock Street

Kind of Pipe

Size

Size of Main

~~Repair~~—Renewal—~~Max Service~~

Com. 12-31-49

Location

Date	Material	Amount	Total	Date	Amount
Oct. 21, '49	Labor	13 80		Oct 8 '49	40 00
Oct. 22, '49	Labor	10 00	23 80	Jan 16 '50	1 47
	10% Overhead		2 38		41 47
	28' - 1" Copper Tubing @.28		7 84	Oct. 22, '49	32 27
	1 - 1" C x 1" I.W.H. S&W		5 60	5' - 1" Copper Tubing @.28	1 40
	2 - 1" x 3/4" Bushings		80	1 - 1" C Corp-cock	4 62
	1 - 1" x 3/4" Elbow		30	1 - 1" C x 1" C Curb-cock	5 60
	Trucking 1 hr. @.75		75	1 - Box & Rod	3 75
			41 47	2 - 3/4" Offset Tail Pieces	74
				Trucking 1 hr. @ .75	75
	Bill Send 1-5-50			Patching 4 x 3	4 00
	Labor				53 13

*Deposited*  
*Paid*

No Charge

TOWN OF LEXINGTON - BOARD OF PUBLIC WORKS

**WATER DIVISION**

The undersigned applies for a supply of water at No..... St. and hereby agrees to comply with the rules and regulations as now, or at any future time, established by the Board of Selectmen.

Am't of Estimate \$.....


Owner .....

Am't Paid \$.....

Address .....

Builder .....

Sketch of Service Here

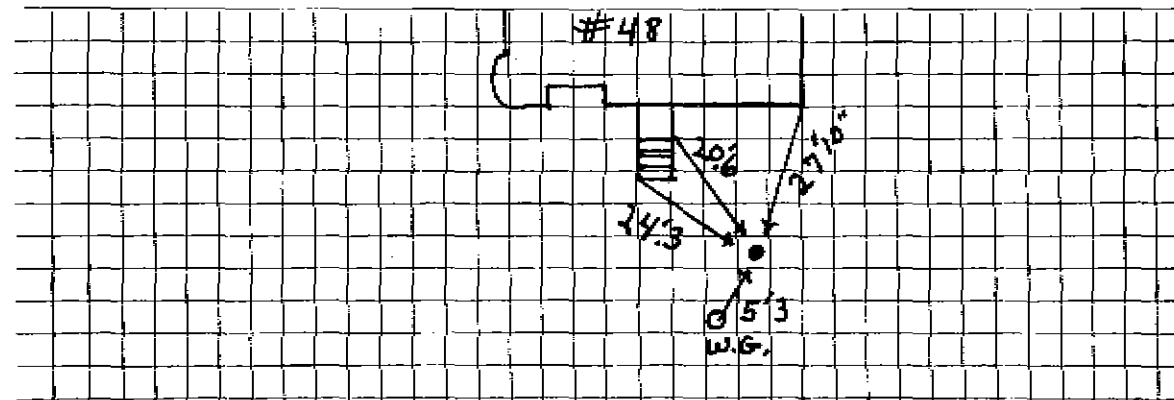

Connection made in ..... Street.

Work completed .....19

Remarks: