

**WATER SERVICE RECORD**

Name *H. Bigelow Moore*

Service No. *11*

Address *50 Hancock Street*

Location

AUG 6 1979

Repair—Renewal—New Service

W.O. #0402


Date	Material	Amount	Total	Date	Amount
<i>6/8/79</i>	<i>Labor</i>	<i>22. 16</i>		<i>5-2-79</i>	<i>150.00</i>
	<i>10% O.H.</i>	<i>2. 22</i>	<i>24. 38</i>	<i>9-2-79</i>	<i>82.68</i>
<i>22'</i>	<i>3/4 Copper @.74</i>		<i>16. 28</i>		<i>67.32</i>
<i>1</i>	<i>3/4 Stop &amp; Waste</i>		<i>17. 10</i>		<i>OUTSIDE W.O.# 0489</i>
<i>1</i>	<i>3/4 X 1/2 Reducer</i>		<i>1. 56</i>	<i>6/11/79</i>	<i>Labor</i>
<i>1/2</i>	<i>Hr. Trucking</i>		<i>1. 50</i>		<i>8" x 3/4" Copper</i>
<i>1</i>	<i>Hr. Backhoe</i>		<i>6. 50</i>	<i>1</i>	<i>Med. Coup. Adapter</i>
			<i>\$ 67. 32</i>	<i>1</i>	<i>3/4" Curb</i>
					<i>Patch 9 X 4 Sidewalk</i>
					<i>" 8 X 4 Sidewalk</i>
					<i>" 5 X 4 Sidewalk</i>
				<i>3 3/4</i>	<i>Hrs. Trucking</i>
				<i>2</i>	<i>Hrs. Case</i>

DATE \_\_\_\_\_

TOWN OF LEXINGTON — BOARD OF PUBLIC WORKS

WATER DIVISION

Sketch of Service Here

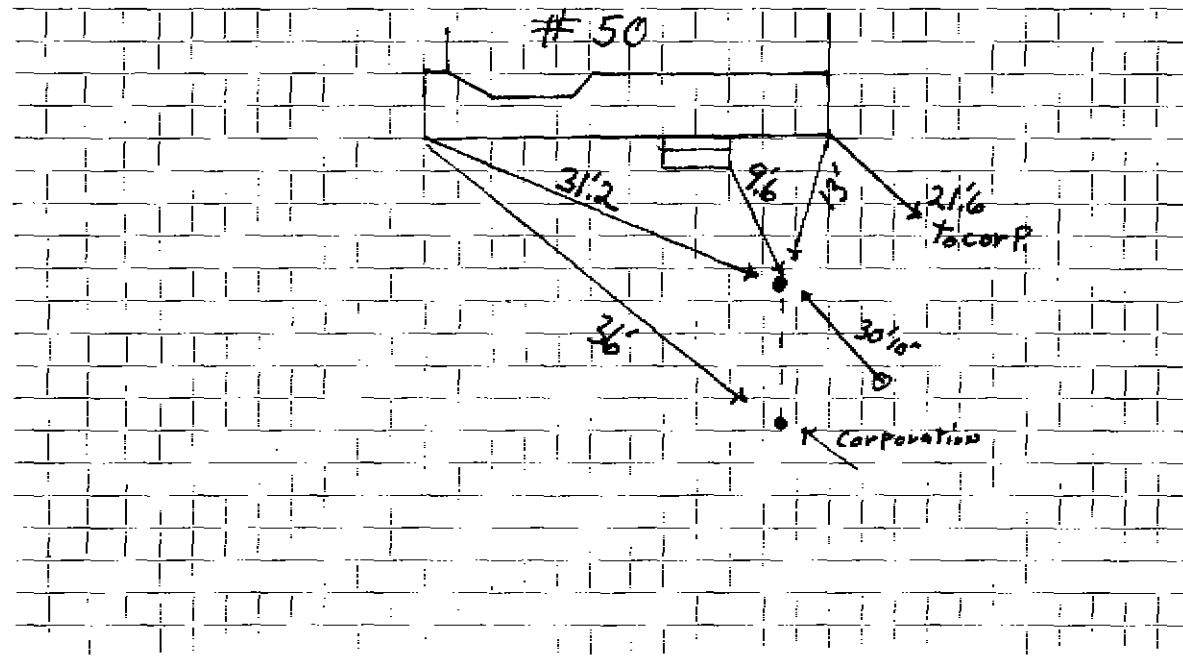

Connection made in ..... Street. Work completed .....

Remarks: .....  
.....  
.....