

## WATER SERVICE RECORD

Service No. 153

Name William A. Moore

Address 52 Hancock Street # 3470

Location

Repair—Renewal—~~NEW SERVICE~~  
XXXX

Comm. 10-28-57


| Date    | Material                           | Amount | Total | Date     | Amount                     |
|---------|------------------------------------|--------|-------|----------|----------------------------|
| 7-24-57 | Labor                              | 55.26  |       | 7-23-57  | Deposit \$ 50 00           |
|         | 10% O.H.                           | 5.53   | 60.79 | 11-13-57 | Paid 36 71                 |
|         | 25' 3/4" Copper tubing @.375       |        | 9.38  |          | <u>\$ 86 71</u>            |
|         | 1 3/4" C x 1/2 I.W.H. Stop & Waste |        | 4.96  |          |                            |
|         | 1 3/4" C x 3/4 I Coupling          |        | 2.90  |          | OUTSIDE W.O. #1180 Renewal |
|         | 1 Style 38 3/4" Repair Clamp       |        | 1.93  | 5/27/80  | Labor                      |
|         | 2 hrs. Compressor @ 3.00           |        | 6.00  | 5'       | 3/4" Copper tubing         |
|         | 1 hr. trucking @.75                |        | .75   | 1        | 3/4" Curb Stop             |
|         |                                    |        | 86.71 | 1        | 3/4" Corp. Adpt.           |
|         |                                    |        |       | 1        | Box & Rod                  |
|         |                                    |        |       | 2        | hrs. Trucking              |
|         |                                    |        |       | 2        | hrs. Town Shovel           |
|         |                                    |        |       |          | Bill sent 10-30-57         |
|         |                                    |        |       |          | \$ 36.71                   |

DATE \_\_\_\_\_

TOWN OF LEXINGTON — BOARD OF PUBLIC WORKS

WATER DIVISION

Sketch of Service Here

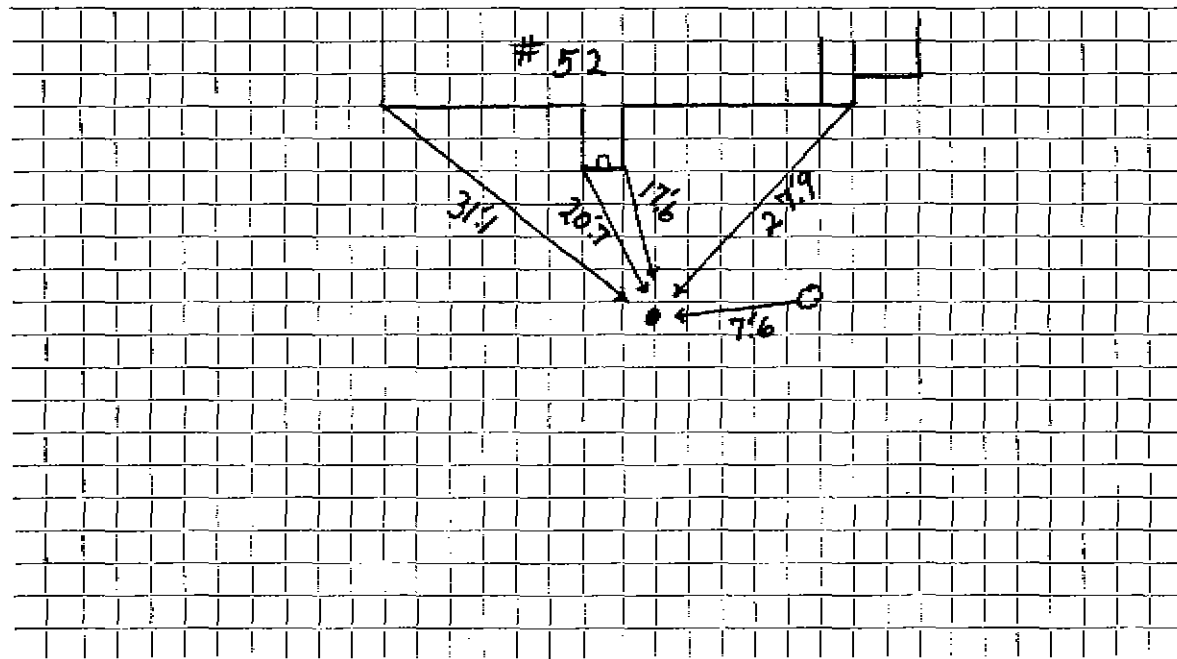

Connection made in ..... Street. Work completed .....

Remarks: .....  
.....  
.....