

Name Clara M. Barbour
 Address 54 Hancock Street.

Service No. # 1162
 # 4875

Location

Kind of Pipe

Size

Size of Main

~~Repair~~—Renewal—~~New Section~~

Location

Date 1938	Material	Amount	Total	Date	Amount
2/2/38	4 hrs. @ 65¢	2 60			
Co. 3 8. 38	30 " 55¢	16 50	19 10	April 4, 1938	33 01
	10% overhead		1 91		
	27' 3/4" Cop. Tub. @ 25¢		6 75		
	1 3/4" S. & W.		3 75		
	2 hrs. trucking @ 75¢		1 50		
			\$ 33 01		
	Labor				

Hadley Press, Inc., Lexington

DATE _____

TOWN OF LEXINGTON—BOARD OF PUBLIC WORKS

WATER DIVISION

The undersigned applies for a supply of water at No. _____ St. and hereby agrees to comply with the rules and regulations as now, or at any future time, established by the Board of Selectmen.

Am't. of Estimate \$ _____


Owner _____

Am't. Paid \$ _____

Address _____

Builder _____

Sketch of Service Here

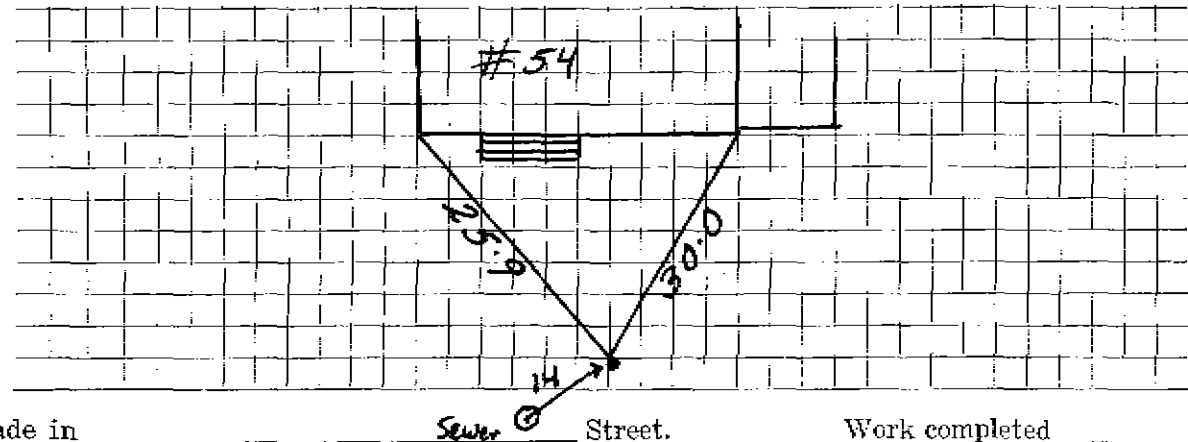

Connection made in _____

Sewer ⑭ Street.

Work completed _____ 19

Remarks: