


DATE 27 October 1994

TOWN OF LEXINGTON — BOARD OF PUBLIC WORKS

WATER DIVISION

Sketch of Service Here

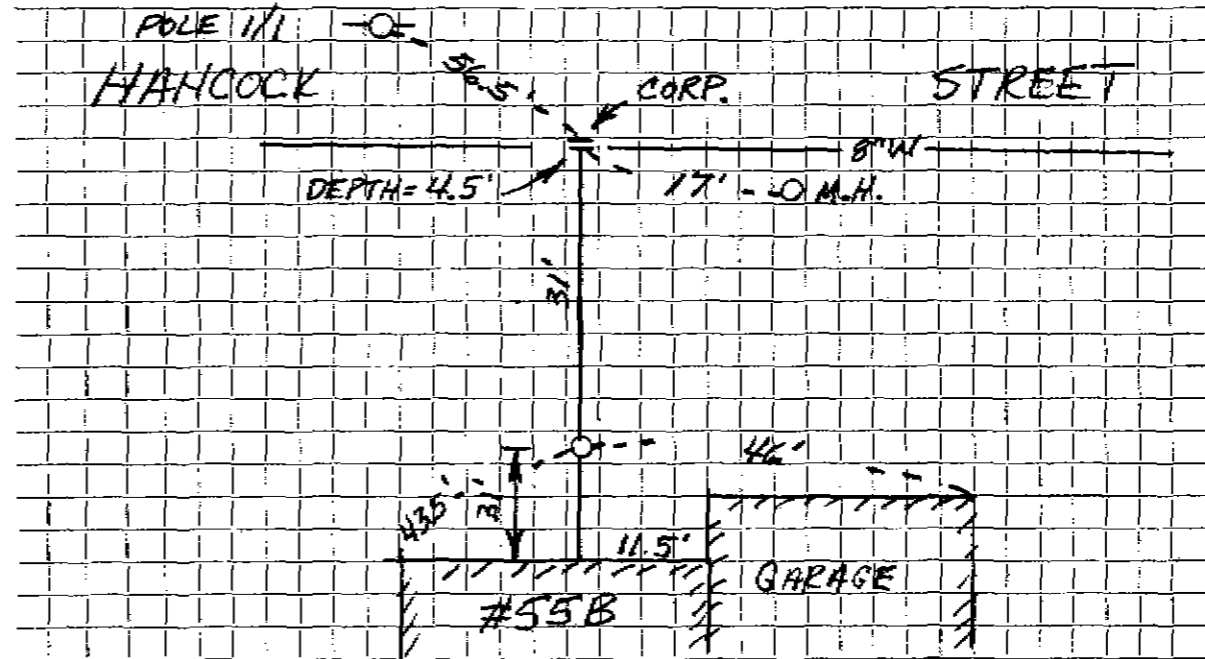

Connection made in HANCOCK STREET Street. Work completed E. BANKS

Remarks:

BOOK 96A

J.W.