

WATER SERVICE RECORD

Name Allen C. Smith

Service No.

268

Address 55 Hancock Street

Location

XORXENMr—Renewal—N6YDSeKXeCX


Cam. 11-21-55

Date	Material	Amount	Total	Date		Amount
9/15/55	Labor	57.64		8-17-55	Deposited	175.00
9/17/55	"	26.60	84.24	11-21-55	Refunded	(15.27)
	10% overhead		8.42		<u>NON CHARGE</u>	15.93
	125' - 1" copper tubing @ .1584	57.30	9/14/55 Labor			53.94
	2 - 1" x 1" unions @ 2.26	4.52	1 - 1" straight tail piece			93
	1 - 1" C x 3/4" I.W.H. stop waste	4.50	1 - 1" offset tail piece			93
	1 hr. trucking	75				55.80
			159.73			

DATE _____

TOWN OF LEXINGTON — BOARD OF PUBLIC WORKS
WATER DIVISION

Sketch of Service Here

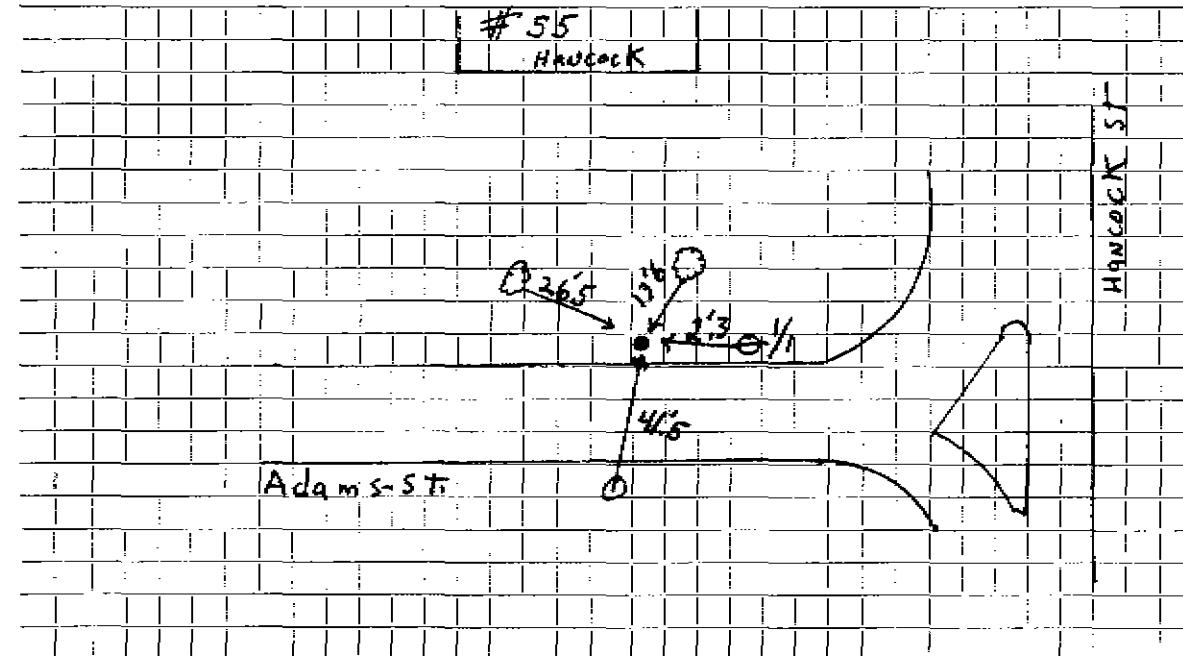

Connection made in Street. Work completed

Remarks:

.....

.....