

WATER SERVICE RECORD

Name John R. Bevan

Service No. 2

Address 56 Hancock Street

Location

Repair—Renewal—~~New Service~~ #6239

AUG 5 1968


Date	Material	Amount	Total	Date	Amount
2/26/68	Labor	79 76		3-23-68	Deposit 150 00
	10% O.H.	7 98	87 74	3-23-68	Retard 21 88
	25' 3/4" copper @ .79		19 75		138 88
1	3/4" stop and Waste		11 13	3-25-69	5' 3/4" Copper
1	hr. trucking		3 00	1-	Curb
1	hr. shoveling		6 50	1-	Corp
	TOTAL COST		\$128 12		Box + Rod
					1- 3/4 adpt
					1- 3/4 Union

DATE _____

TOWN OF LEXINGTON — BOARD OF PUBLIC WORKS

WATER DIVISION

Sketch of Service Here

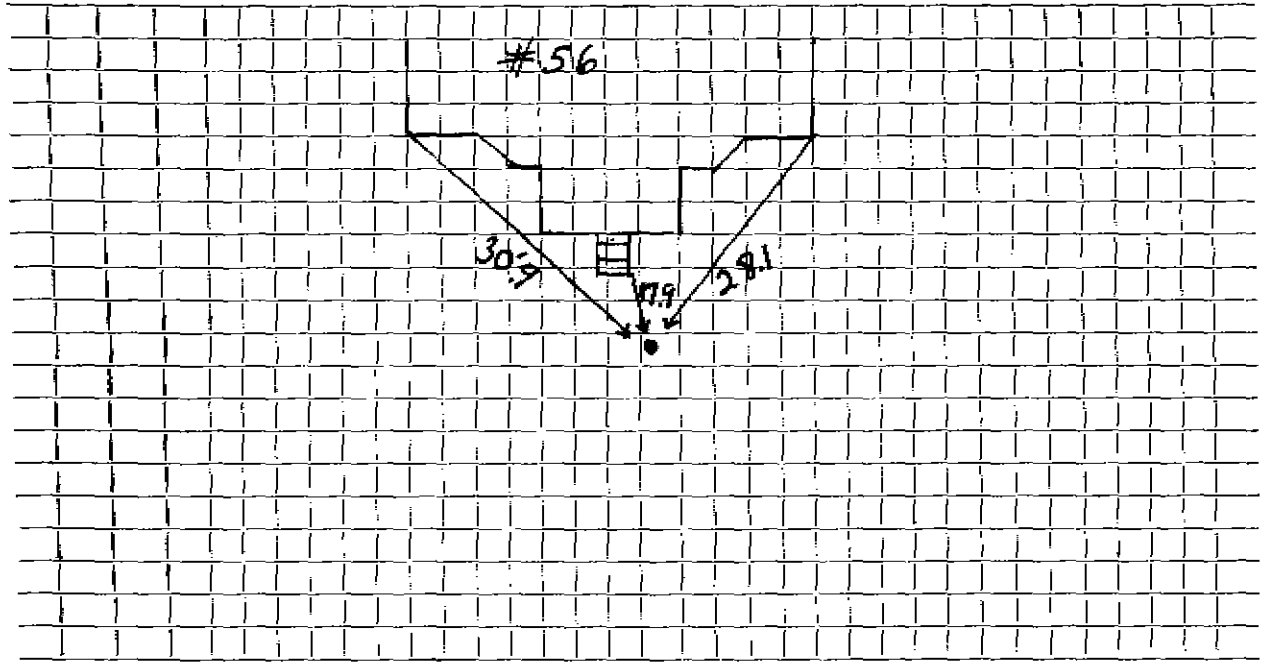

Connection made in Street. Work completed

Remarks:
.....
.....