

WATER SERVICE RECORD

#5576

#5517

Name Moore Realty Trust

Service No. 248

Address 57 Hancock Street + OLD SERVICE ADAMS ST.

Location

Repair - Renewal - New Service


Comm 12-12-60

Date	Material	Amount	Total	Date		Amount
11/3/60	Labor	1 94		10-26-60	Deposit	50 00
	10% overhead	19		12-13-60	Returned	18 00
			2 13			31 40
	55' 3/4" Copper tubing @.42		23 10			
	1 3/4" Cx 1/2" IWH stop & waste		6 17		CURB TO MAIN	
			31 40		Labor	1 61
				18'	3/4" copper tubing @.42	7 16
				1	3/4" C Corp Cock	4 91
				1	3/4" C Curb Cock	6 28
				1	Box & Rod	4 90
				1	3/8" Straight Tl. Pc.	50
				1	1/2" Offset Tail Pc.	50
				5/29/86	30.5' 1" COPPER	25 86
					1 1" CORP	
					1 1" Curb	
					1 1"x3/4 Union	
					* Copy (200) to 5/12/84 238	

TOWN OF LEXINGTON — BOARD OF PUBLIC WORKS

WATER DIVISION

Sketch of Service Here

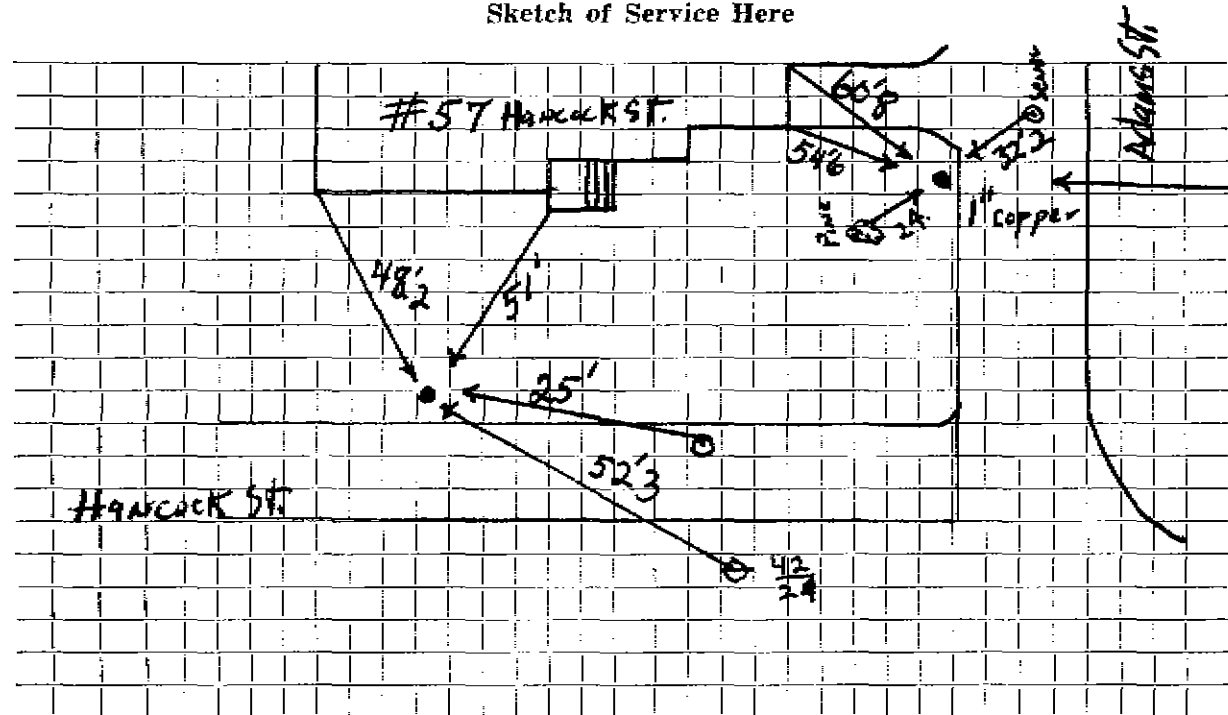

Connection made in Hancock St. Street. Work completed

Remarks:
.....
.....