

WATER SERVICE RECORD

Name *Rosemarie Johnston*

Service No.

Address *58 Hancock Street*

Location

~~Repair/RENEWAL~~—New Service #4672 *Bruce J. McKee, Inc.*


Date	Material	Amount	Total	Date	Amount
8/30/88	18' 3/4" Copper				
	3/4" Valve				
				7/3/80	Renewal #1267
					Labor
				6'	3/4" Copper tubing
				1	3/4" Corp Adapter
				1	3/4" Curb Cock
				1	Box & Rod
				1	Lead Lined Coupling
				1	5" Nipple
				1	1" Repair Clamp
				1/2	Ton Hot Top
				5	Hrs. Trucking
				2	Hrs. Town Shovel

DATE _____

TOWN OF LEXINGTON — BOARD OF PUBLIC WORKS

WATER DIVISION

Sketch of Service Here

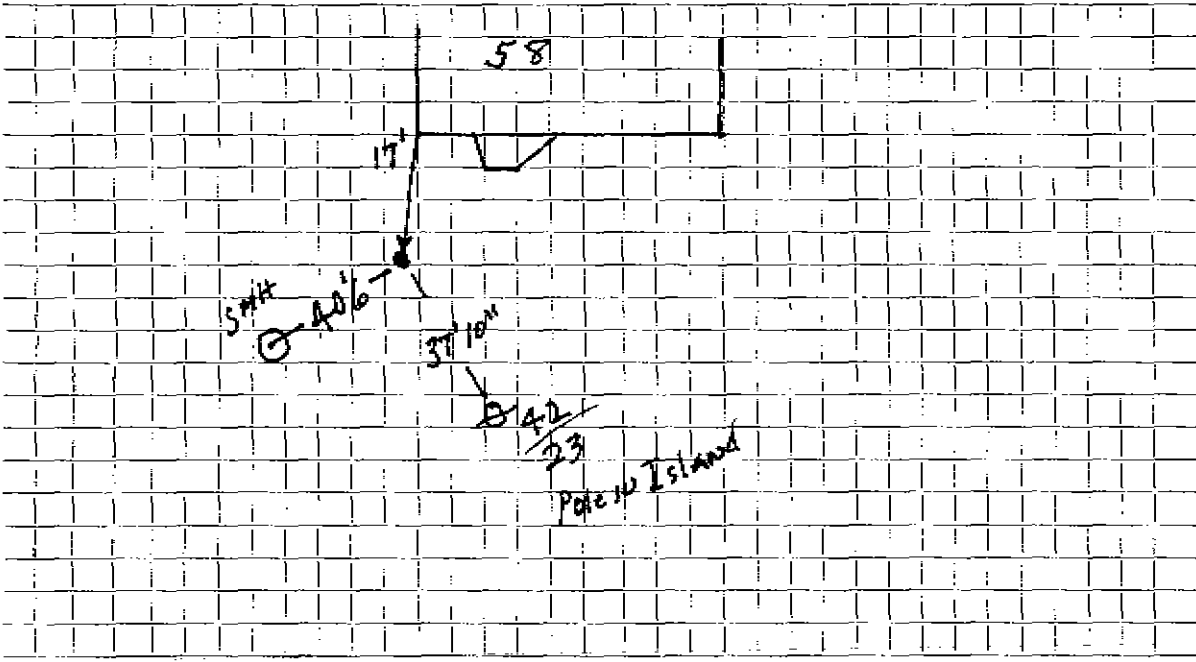

Connection made in Street. Work completed

Remarks:

.....

.....