




DATE \_\_\_\_\_

TOWN OF LEXINGTON — BOARD OF PUBLIC WORKS

WATER DIVISION

Sketch of Service Here

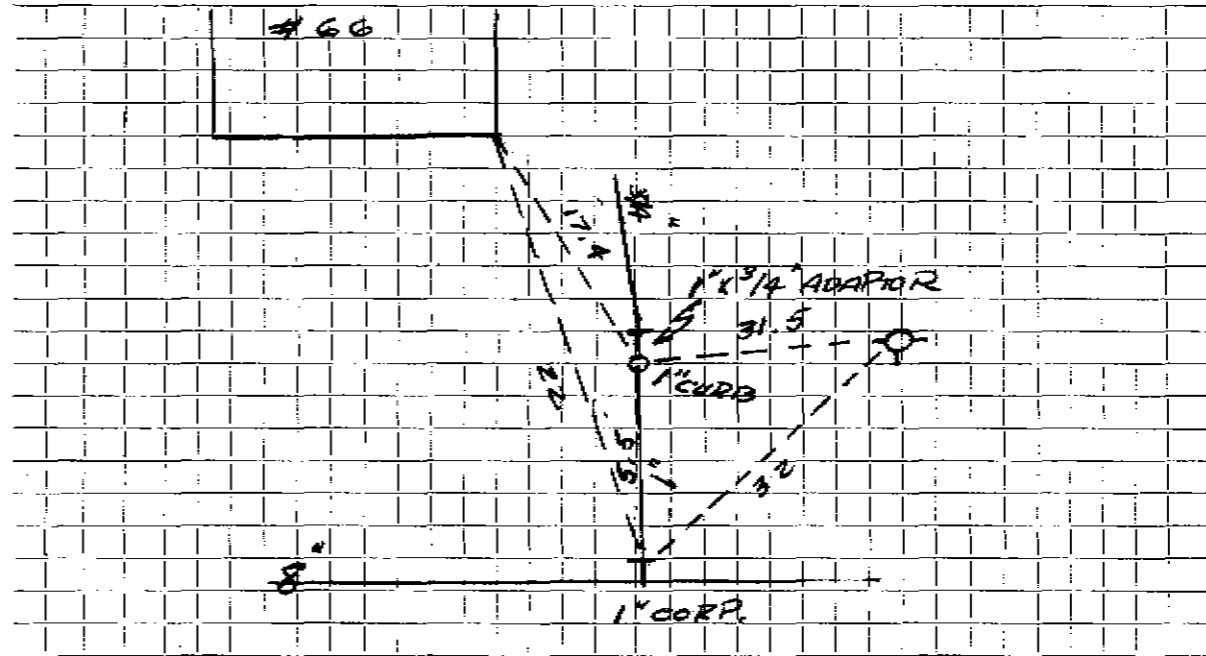

Connection made in HANCOCK ..... Street. Work completed .....

Remarks: NEW 8" DI. MAIN, NEW 1" COPPER SERV. .....

.....

.....