


DATE _____

TOWN OF LEXINGTON — BOARD OF PUBLIC WORKS

WATER DIVISION

Sketch of Service Here

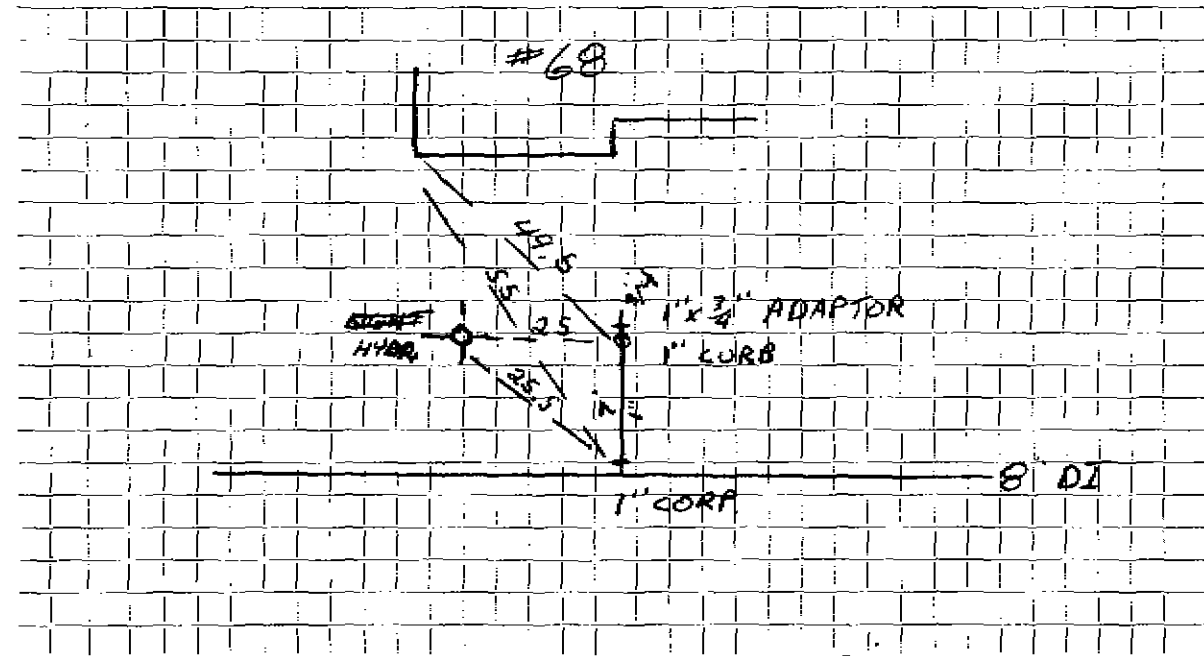

Connection made in HANCOCK Street. Work completed 6-2-86

Remarks: NEW 8" DI MAIN, NEW 1" SERV. TO CURB