




DATE \_\_\_\_\_

TOWN OF LEXINGTON — BOARD OF PUBLIC WORKS

WATER DIVISION

Sketch of Service Here

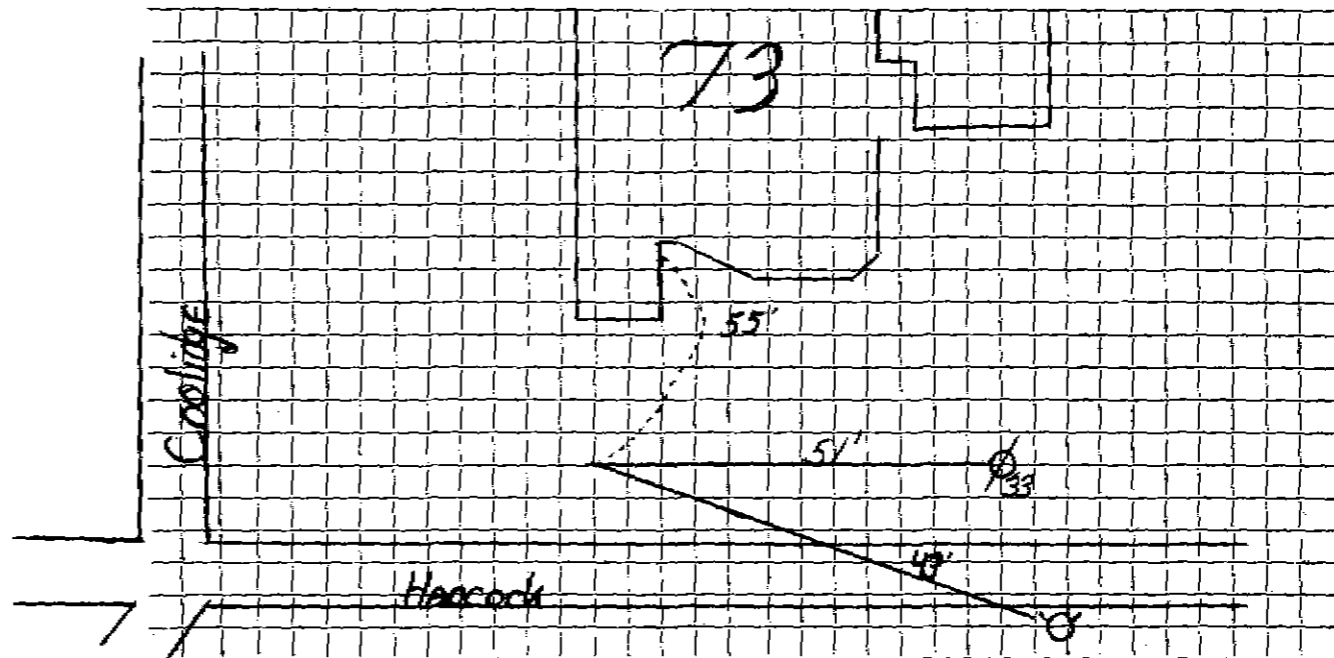

Connection made in ..... Street. Work completed .....

Remarks: .....

.....

.....

WATER SERVICE RECORD

Name

Service No.

Address 73 HANLOCK ST

Location

Repair—Renewal—New Service


Date	Material	Amount	Total	Date	Amount
6-3-56	1 CORP. 1 CURB w/BOX 1" x 3/4" ADAPTER 29 LF 1" COPPER				
8/22/58	55' 3/4 COPPER 1 3/4 x 1/2 SAW				

DATE \_\_\_\_\_

TOWN OF LEXINGTON — BOARD OF PUBLIC WORKS

**WATER DIVISION**

Sketch of Service Here

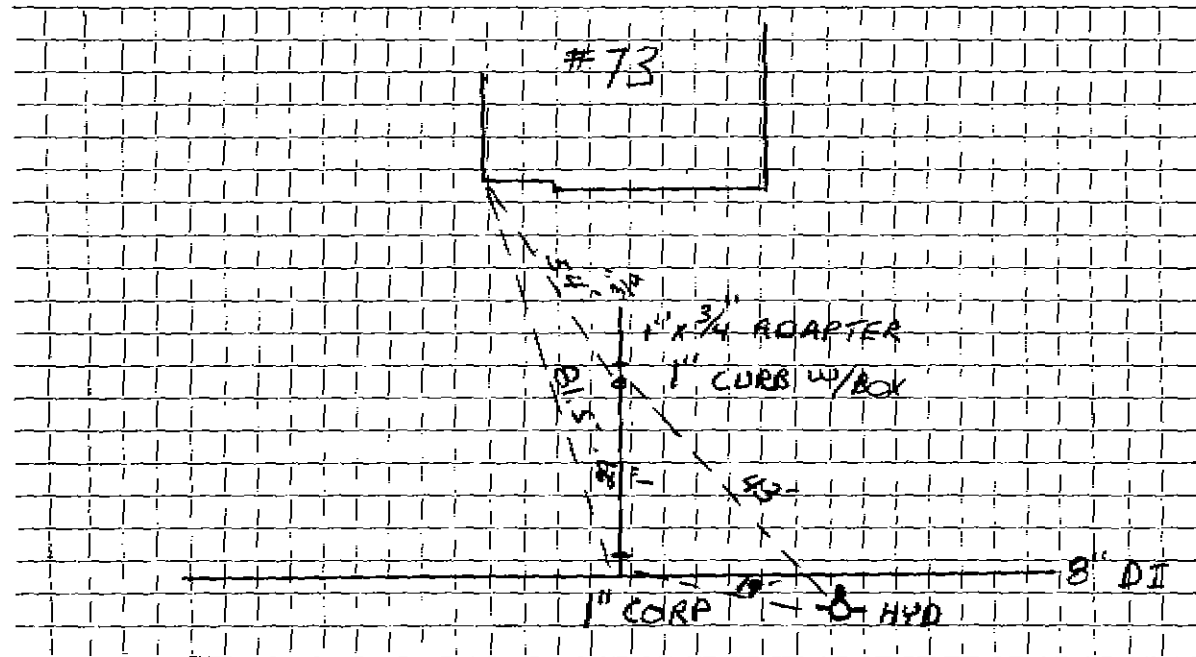

Connection made in ..... HANCOCK ..... Street. Work completed ..... 6-3-86 .....

Remarks: NEW 8" DI MAIN, NEW 1" SERV TO CURB. .....