

WATER SERVICE RECORD

Name

Service No.

Address 74 HANCOLK ST

Location

Repair—Renewal—New Service


Date	Material	Amount	Total	Date	Amount
6-2-86	1" CORP.				
	1" CORB w/BOX				
	1" X 3/4" ADAPTOR				
	13 LF 1" COPPER				
4/8/70	3/4 COPPER				
	3/4 S & W				

DATE _____

TOWN OF LEXINGTON — BOARD OF PUBLIC WORKS

WATER DIVISION

Sketch of Service Here

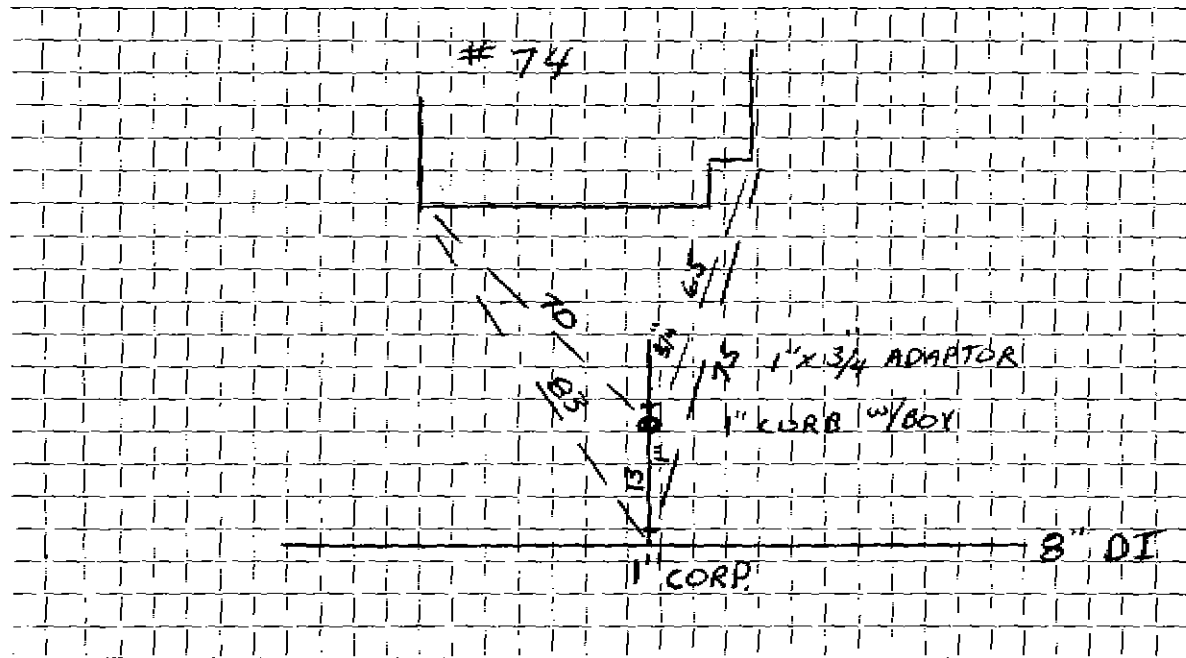

Connection made in HANCOLK Street. Work completed 6-2-86

Remarks: NEW 8" DI MAIN, NEW 1" SERV. TO CURB