

WATER SERVICE RECORD

Name

Service No.

Address 75 HANCOCK ST.

Location

Repair—Renewal—New Service


Date	Material	Amount	Total	Date	Amount
6-3-86	1" COPR.				
	1" COPR w/BOX				
	1" REDUCER				
	1" NIPPLE				
	1" COUPLING				
	23 LF 1" COPPER				
4/11/31	33' 1" C.L.P.				
	1 S & W				

DATE _____

TOWN OF LEXINGTON — BOARD OF PUBLIC WORKS

WATER DIVISION

Sketch of Service Here

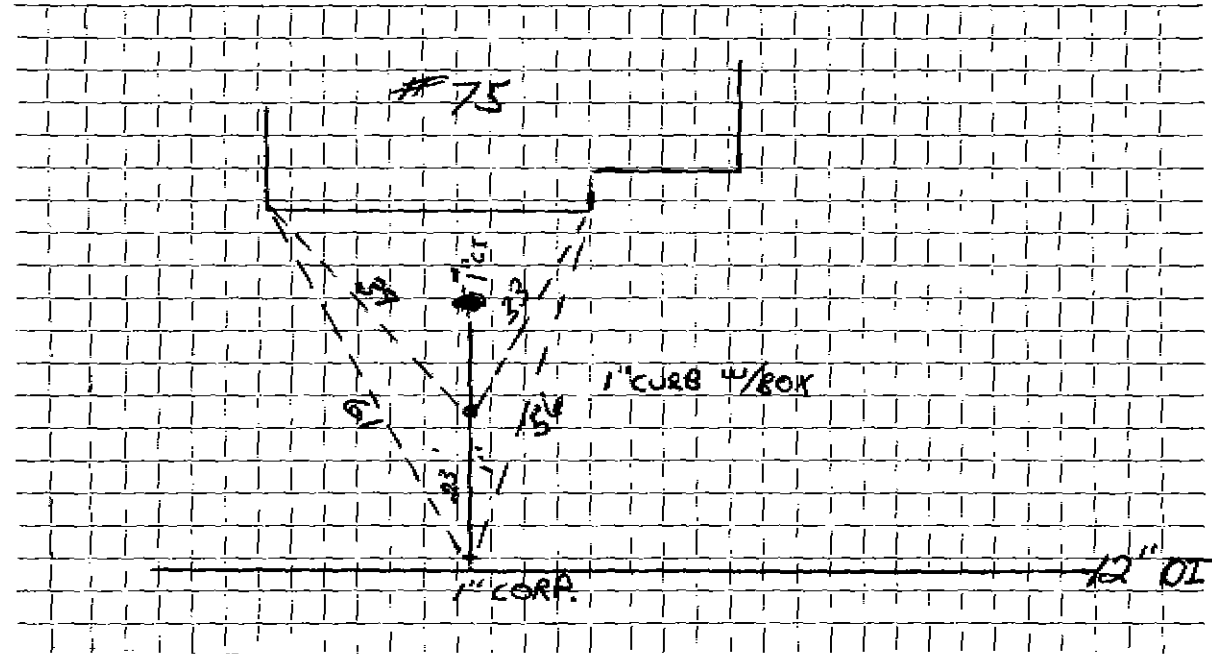

Connection made in HANCOCK Street. Work completed 6-3-86

Remarks: NEW 12" DI MAIN, NEW 1" SERV TO CURB