

WATER SERVICE RECORD

Name

Service No.

Address 78 HANLOCK ST (LOT 1)

Location LOT # 184

Repair—Renewal—New Service


Date	Material	Amount	Total	Date	Amount
6-2-86	1" COPR.	23.00			
	1" CURB w/BOX	65.00			
	14 LF 1" COPPER	@ 12.75 =	178.50		
10/28/86	49' 1" COPPER				
	1 1" BALL VALVE				

DATE _____

TOWN OF LEXINGTON — BOARD OF PUBLIC WORKS

WATER DIVISION

Sketch of Service Here

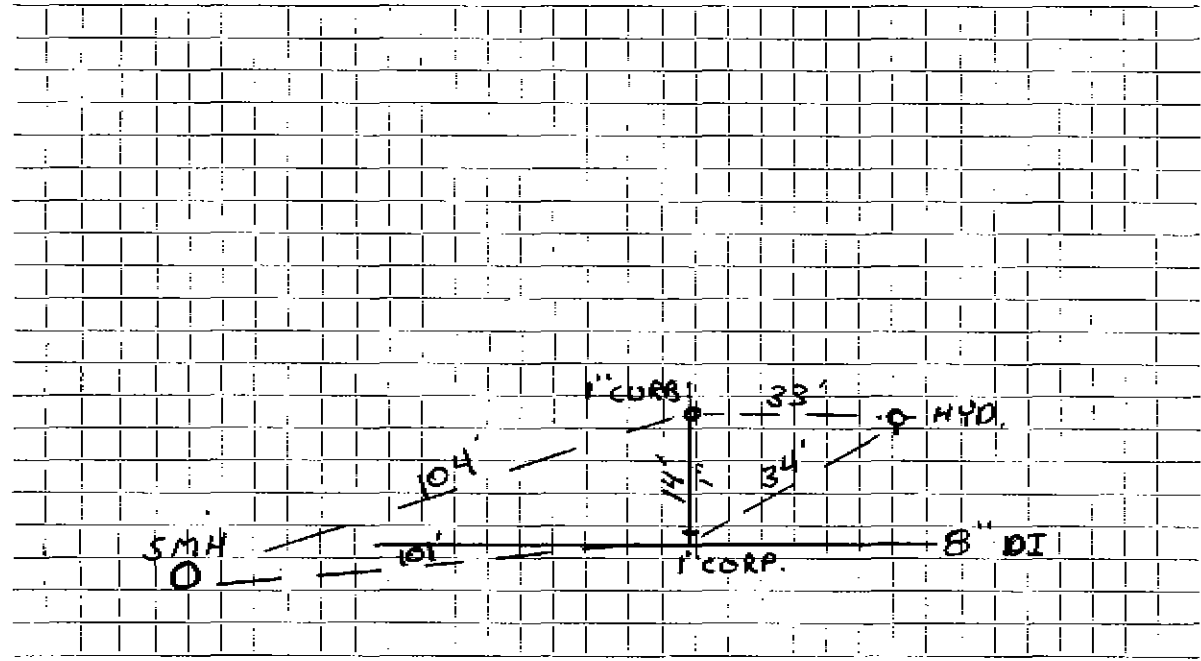

Connection made in HANCOCK Street. Work completed 6-2-86

Remarks: NEW 8" DI MAIN, NEW 1" SERV. TO CURB