

WATER SERVICE RECORD

Name

Service No.

Address 79 HANCOCK ST

Location

Repair—Renewal—New Service


Date	Material	Amount	Total	Date	Amount
6-4-86	1-3/4" COPR. 1-3/4" CURB w/BOX 23.8 LF 3/4 COPPER				
3/28/67	IN				
	30' 3/4 COPPER				
	1 3/4 Union				
	1 3/4x 1/2 STOP & W				

DATE _____

TOWN OF LEXINGTON — BOARD OF PUBLIC WORKS

WATER DIVISION

Sketch of Service Here

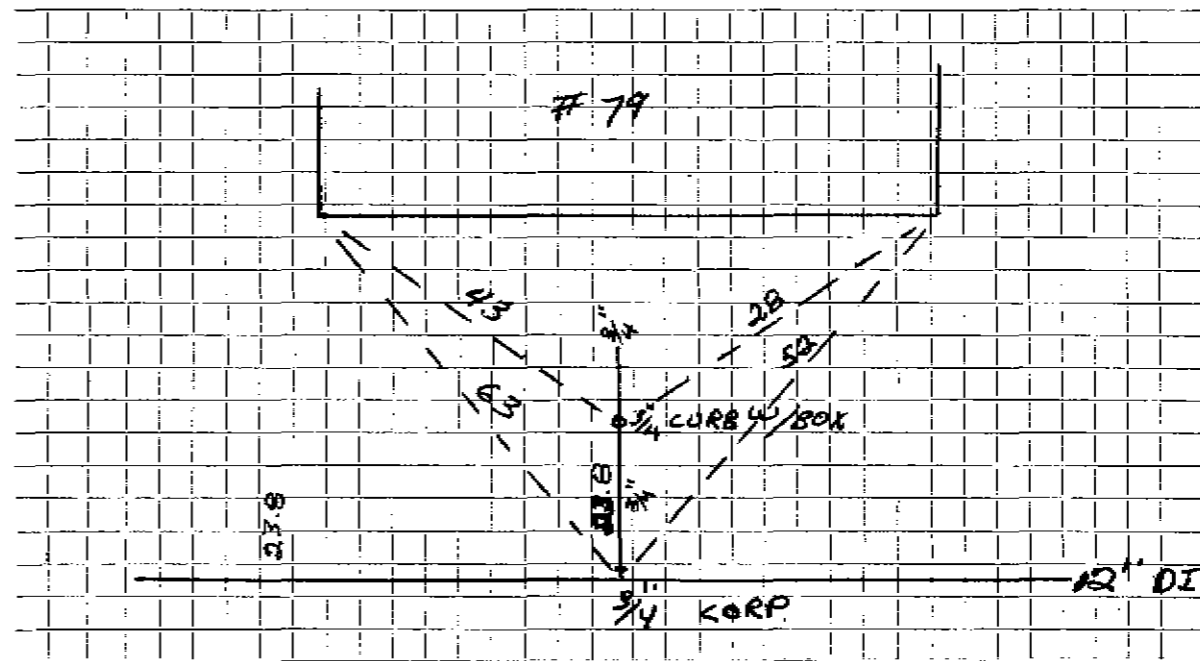

Connection made in HANCOCK Street. Work completed 6-4-86

Remarks: NEW 12" DI MAIN, NEW 3/4" SERV. TO CURB