

WATER SERVICE RECORD

Name

Service No.

Address

80 B HANCOCK ST

Location

Repair—Renewal—New Service


Date	Material	Amount	Total	Date	Amount
6-5-86	1-3/4" CORP. 1-3/4" CURB w/BOX 15 LF 3/4" COPPER				
8/5/53	46' 3/4 COPPER 1 3/4 x 1/2 STW				

DATE _____

TOWN OF LEXINGTON — BOARD OF PUBLIC WORKS

WATER DIVISION

Sketch of Service Here

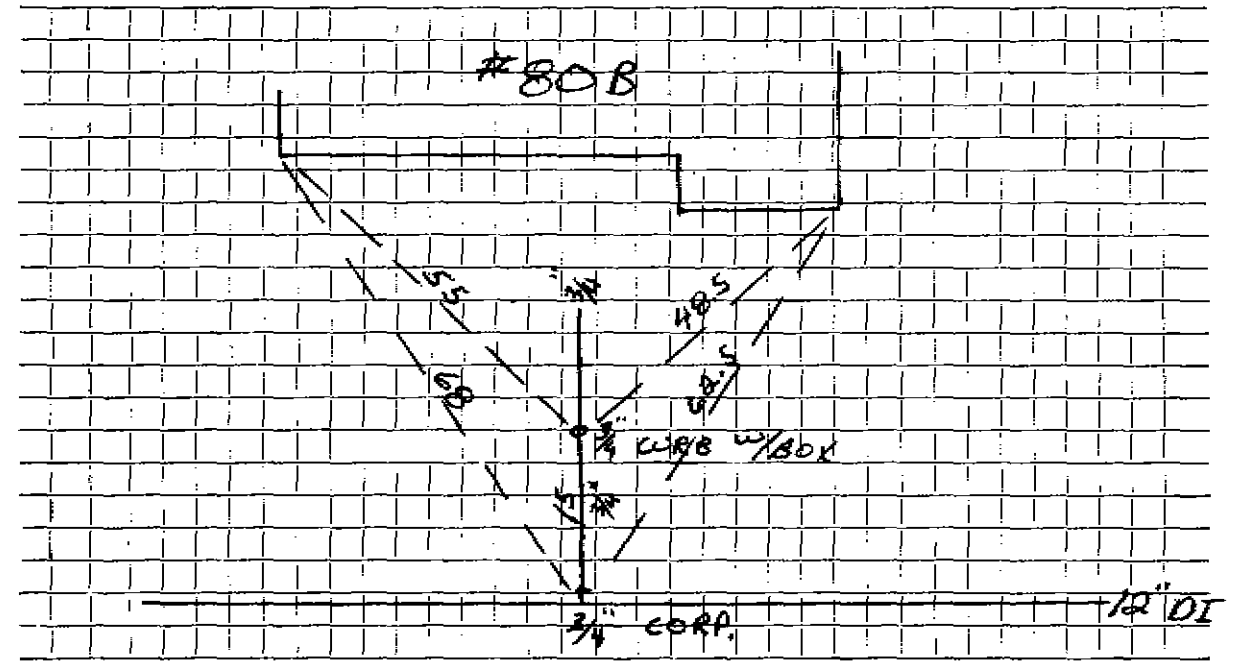

Connection made in ... HANLOCK ... Street. ... Work completed ... 6-5-86 ...
Remarks: ... NEW 12" DI MAIN, NEW 3/4" SERV. TO CURB ...