

WATER SERVICE RECORD

Name

Service No.

Address 80 HANCOCK ST.

Location

Repair ~~Renewal~~ New Service


Date	Material	Amount	Total	Date	Amount
C-20-86	3/4" COPP				
	3/4" CURB				
	26 LF 3/4" COPPER				
5/3/60	58' 3/4 COPPER				
	1 3/4 UNION				
	1 3/4 x 1/2 S L W				

DATE _____

TOWN OF LEXINGTON — BOARD OF PUBLIC WORKS

WATER DIVISION

Sketch of Service Here

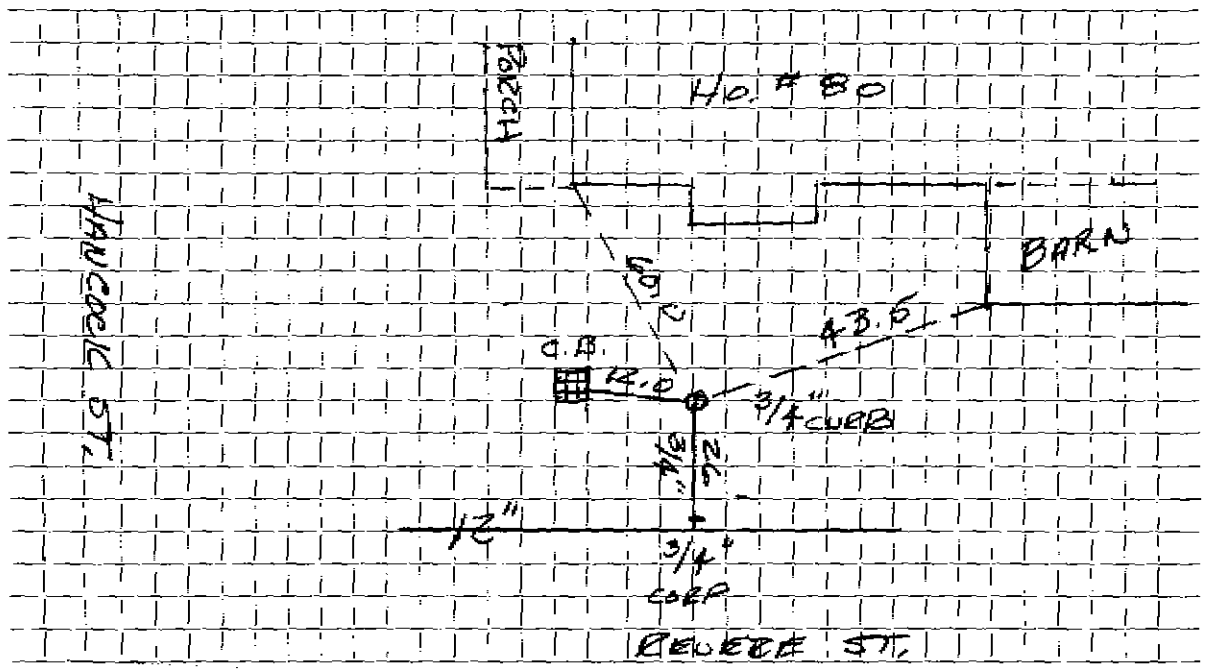

Connection made in REVERE Street. Work completed

Remarks: TAPPED OFF 12" MAIN

.....
.....