


DATE 12-4-2000

TOWN OF LEXINGTON — BOARD OF PUBLIC WORKS

WATER DIVISION

Sketch of Service Here

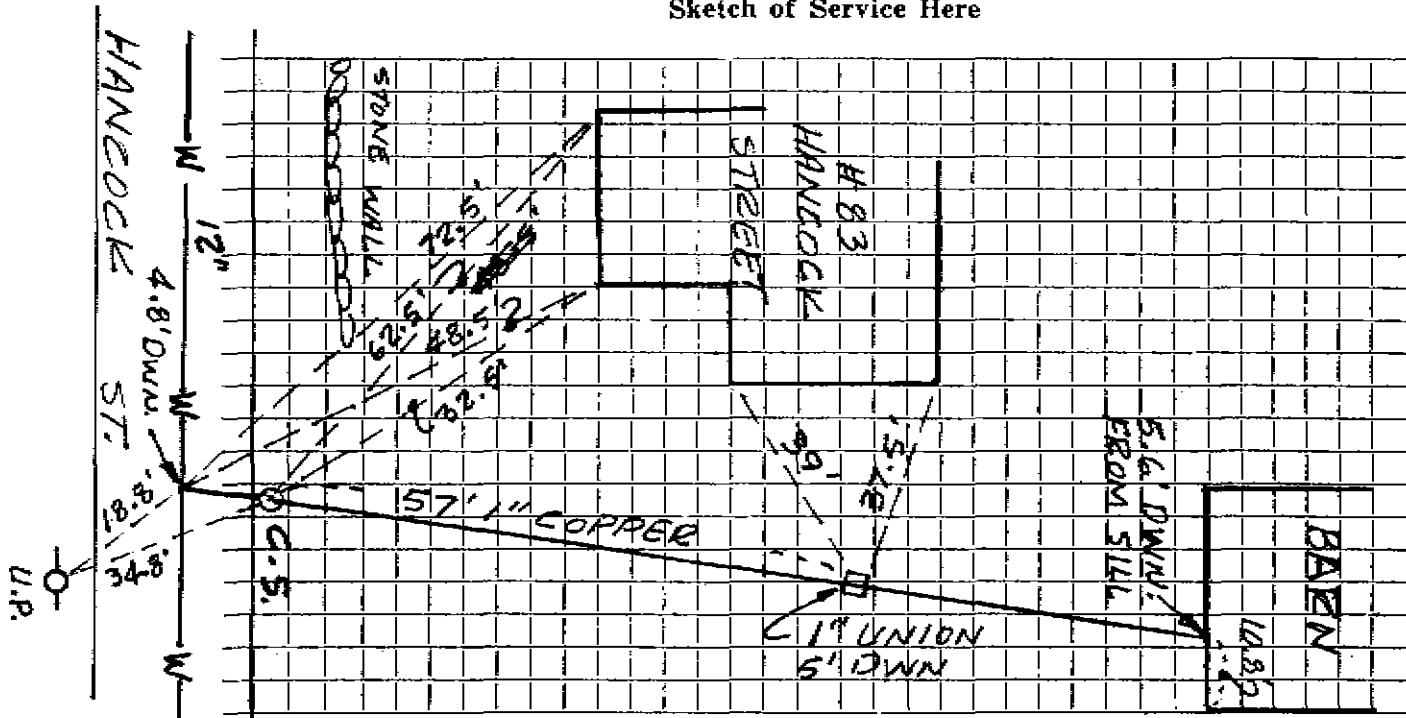

Connection made in HANCOCK Street. Work completed A. CARDILLO & SONS

Remarks: -FLOW FILL FOR BACKFILL MATERIAL
8" H.P. GAS MAIN CROSSES COPPER SERVICE / 8" ABANDONED GAS MAIN
GAS 10' FROM CURB