


TOWN OF LEXINGTON — BOARD OF PUBLIC WORKS

WATER DIVISION

Sketch of Service Here

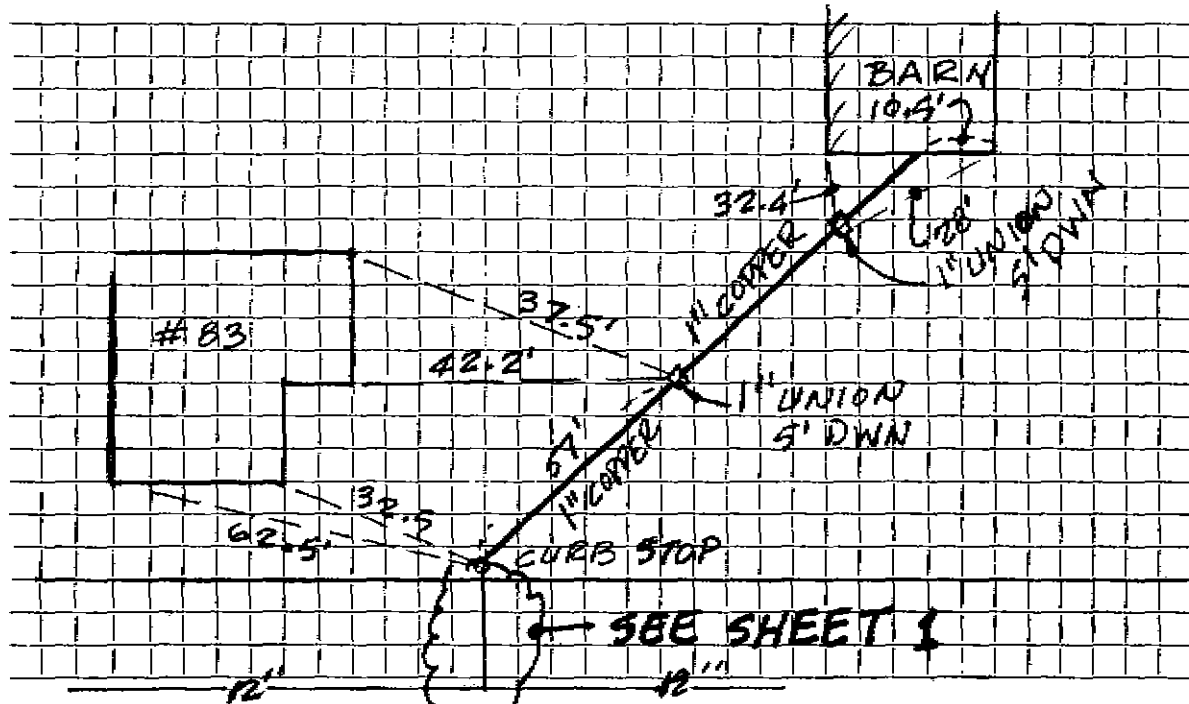

Connection made in Street. Work completed

Remarks: **INSTALLED BY: A. CARDILLO & SONS.**
INSPECTED BY: P.K.

WATER SERVICE RECORD

Name Leslie Bull

Service No. 255

Address 83 Hancock Street

Location

-Repair—Renewal—New Service

Comm 3-16-59


Date	Material	Amount	Total	Date	Amount
11/21/58	Labor	20 33		11-12-58	75 00
	10% overhead	2 03	22 36	3-16-59	34 52
	19' - 3/4" Copper tubing @ .37	7 03			40 48
	1 - 3/4" O x 1/2" I.W.H. Stop & Waste	5 84			
	1 hr. Pippin Backhoe	4 50			NON CHARGE
	1 hr. Trucking		75	11/21/58	Labor 28 93
			40 48	27' - 3/4" Copper tubing @ .37	9 99
				1 - 3/4" C. Corp Cock	4 64
				1 - 3/4" C. Curb Cock	6 03
				1 Box & Rod	5 00
				1 hr. Pippin Backhoe	4 50
				1 hr. Trucking	75
				14x3 Patch	14 00
					73 84
				3/1/98	2-3/4 UNIONS
					2'-3/4 COPPER

DATE _____

TOWN OF LEXINGTON — BOARD OF PUBLIC WORKS

WATER DIVISION

Sketch of Service Here

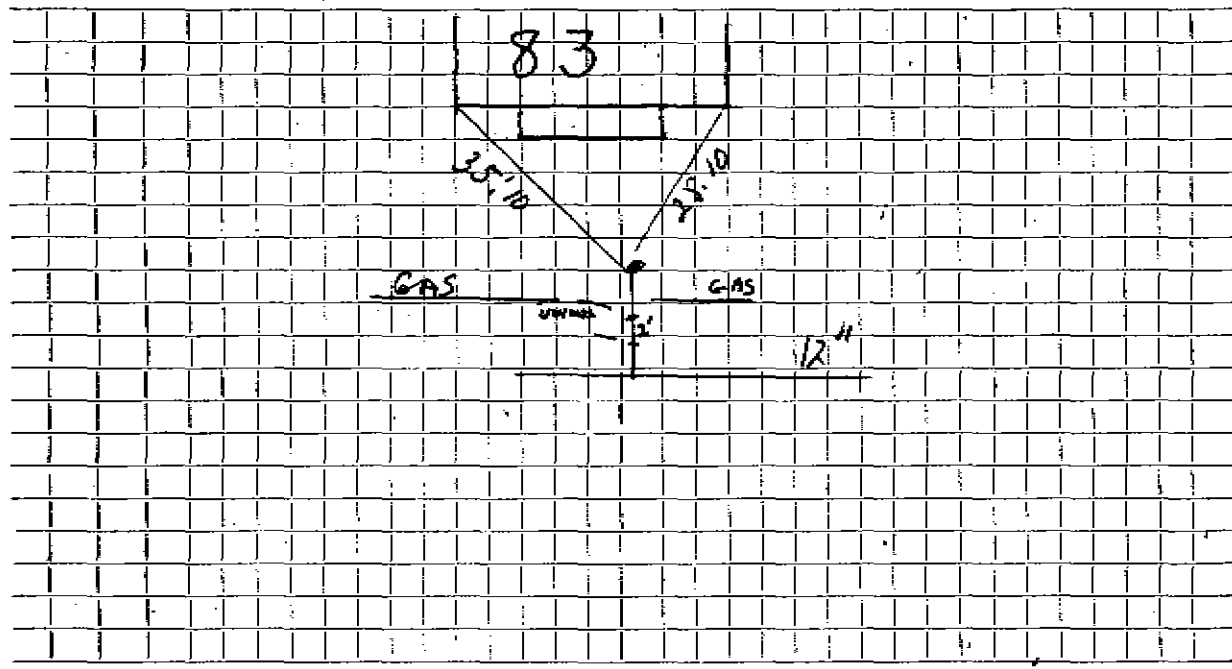

Connection made in Street. Work completed


Remarks:
.....
.....

DATE NOVEMBER 29, 2000

TOWN OF LEXINGTON — BOARD OF PUBLIC WORKS

WATER DIVISION

Sketch of Service Here

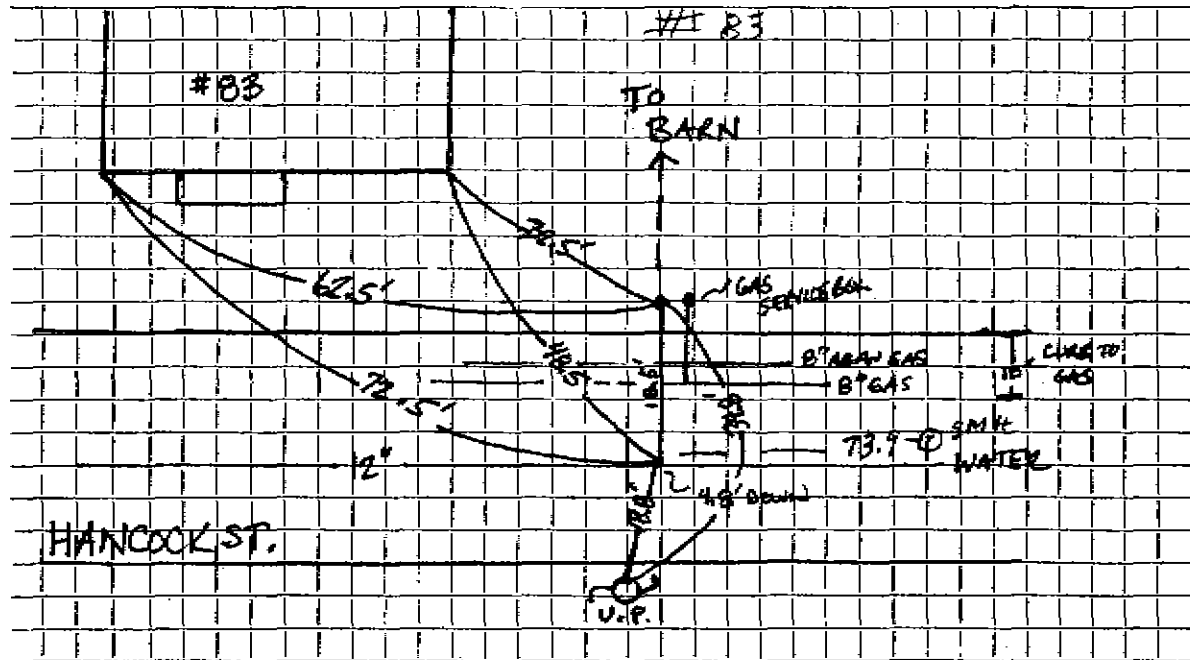

Connection made in HANCOCK (CENTERLINE) Street.

Work completed

Remarks: - FLOW FILL FOR BACKFILL MATERIAL

- 8" HP GAS MAIN CROSSES COPPER SERVICE / & 8" ABANDONED GAS MAIN : GAS 10' FROM CORB

D.S.