


DATE _____

TOWN OF LEXINGTON — BOARD OF PUBLIC WORKS

WATER DIVISION

Sketch of Service Here

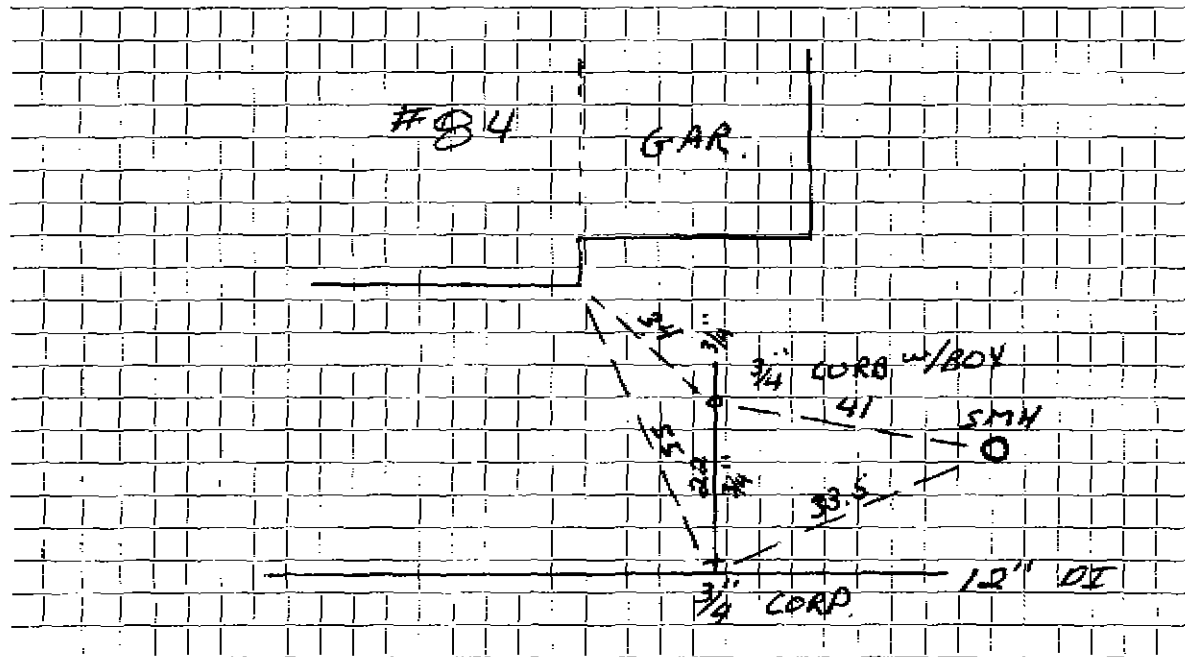

Connection made in MANCOCK Street. Work completed 6-5-86

Remarks: NEW 12" DI MAIN, NEW 3/4" SERV. TO CURB.