

WATER SERVICE RECORD

Name

Service No.

Address

Location 85 HANCOCK ST

Repair—Renewal New Service

J McLaughlin


Permit 1277

Date	Material	Amount	Total	Date	Amount
7/20/99	17' 1 1/2" COPPER				
	1 1.5 SERVICE SADDLE				
	1 1.5 CORP				
	1 1.5 CURB				
	1 BUFFALO BOX				
1999	158' 1.5 COPPER				
	60' ROLLS				
	3 1.5 UNIONS				

TOWN OF LEXINGTON — BOARD OF PUBLIC WORKS

WATER DIVISION

Sketch of Service Here

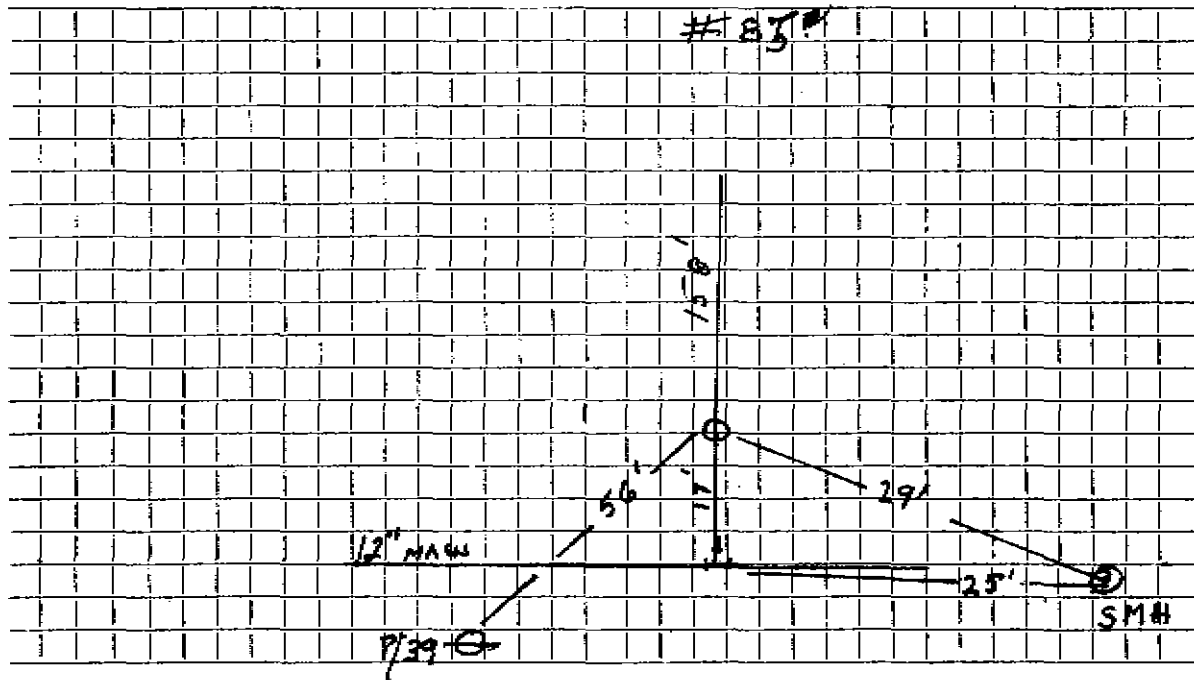

Connection made in ..... Street. Work completed .....

Remarks: WATER + SEWER IN SAME TRENCH 119 ST. TO CURB SEWER 17' DOWN