

WATER SERVICE RECORD

Name

Service No.

Address 88 HANCOLK ST.

Location

Repair—Renewal New Service


Date	Material	Amount	Total	Date	Amount
6-5-86	1-3/4" COPP. 1-3/4" CURB W/BOX 18.5 LF 3/4" COPPER				
7/14/48	75' 3/4 COPPER 1 3/4 X 3/4 S+W 2 3/4 UNIONS 1 3/4 x 1/2 Bush				

DATE \_\_\_\_\_

TOWN OF LEXINGTON — BOARD OF PUBLIC WORKS

**WATER DIVISION**

Sketch of Service Here

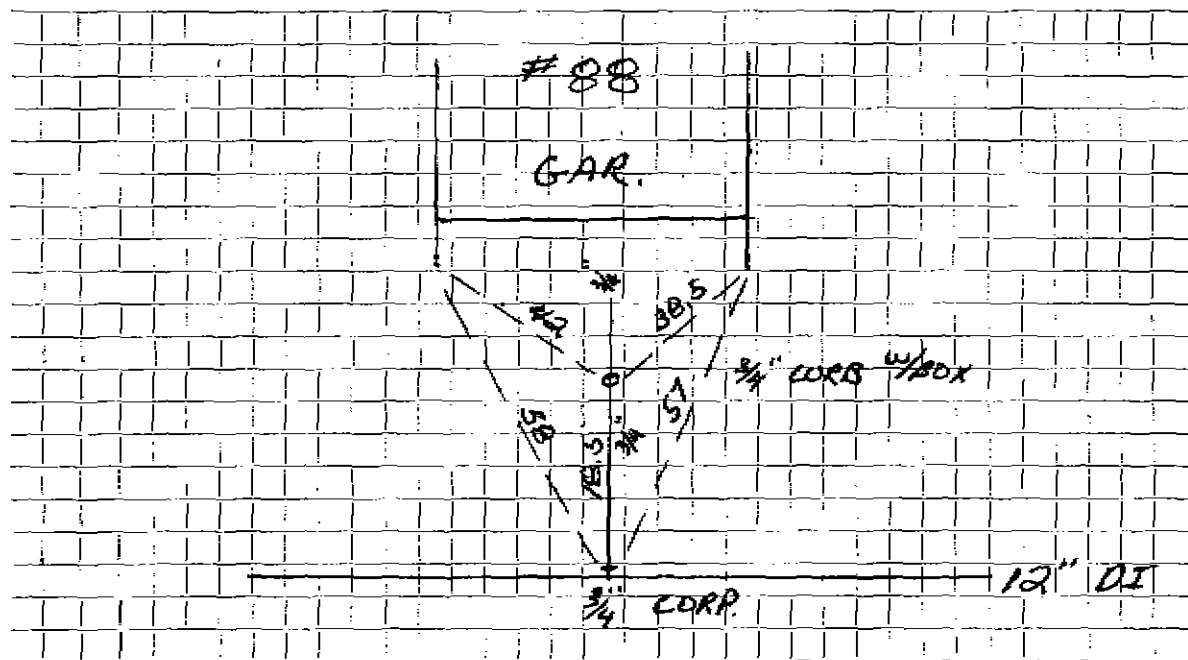

Connection made in HANCOCK Street. Work completed 6-5-86

Remarks: NEW 12\" DI MAIN, NEW 3/4\" SERV. TO CURB.