

WATER SERVICE RECORD

Name William B. Hoyt

Service No. 148

Address 89 Hancock St.,

#1766

Location

~~Repair~~ ~~Renewal~~ ~~New Service~~


Comm 11-13-61

Date	Material	Amount	Total	Date	Amount
10/16/61	Labor	76.06		10-2-61	Deposit 225 00
10/17/61	"	33.50	109 56	10-5-61	paid 10 30
	10 % O.H.	10 96	120 52		235 30
	120' 1" Copper Tubing @.56		67 20	6/9/86	
	1 1" X 3/4" I.W.H. Stop & Waste		6 96	10/17/61	Labor NON-CHARGE 20 11
	1 1" 3 Part Union		3 98	10'	1" Copper Tubing @.56 7 84
	1 3/4" CX 1/2 Bushing		64	NEW	1 1" C Corp Cock 7 33
	6 Hrs. Pippin @ 5.00		30 00	NEW	1 1" C Curb Cock 8 06
	2 Hrs. Trucking @ 3.00		6 00		1 Bow & Rod 4 90
			235 30		1 Hr. Trucking @ 3.00 3 00
					2 Hrs. Pippin Shovel @ 5.00 10 00
					12 X 3 Patch 12 00
					1 1/2 Straight Tailpiece 50
					1 1/2 Offset Tailpiece 50
					74 22

TOWN OF LEXINGTON — BOARD OF PUBLIC WORKS

WATER DIVISION

Sketch of Service Here

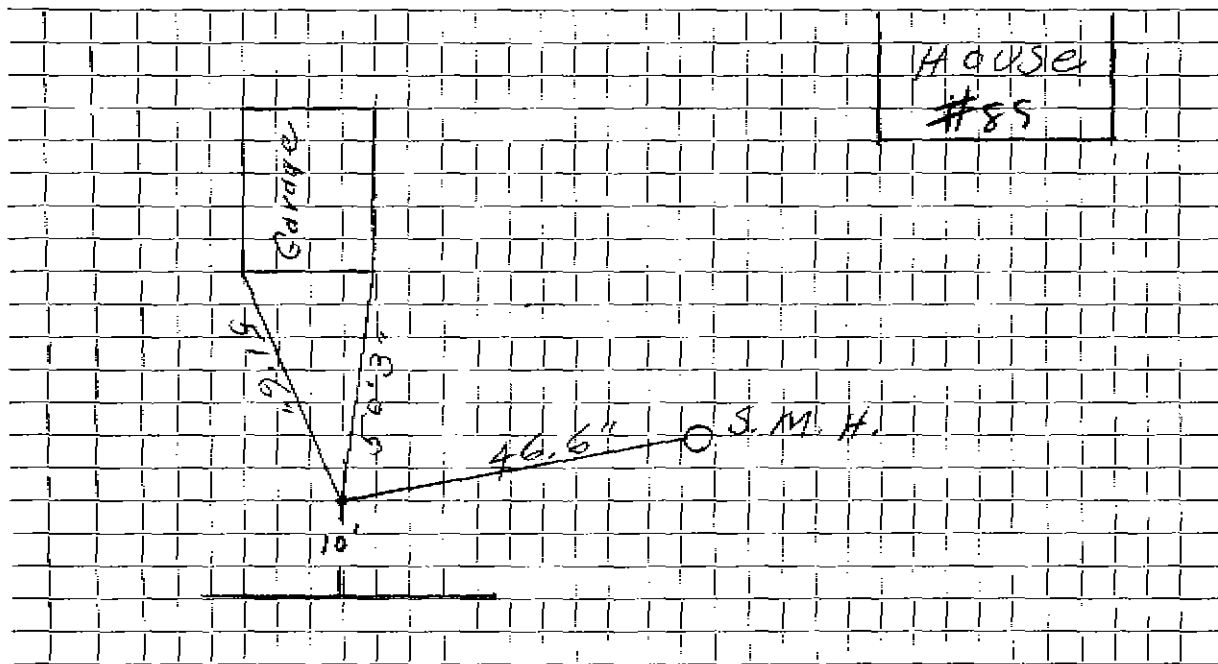

Connection made in Street. Work completed

Remarks: ...old... Corp... shut... off.....

...NEW 1" TIED TO 12" MAIN.....