


TOWN OF LEXINGTON — BOARD OF PUBLIC WORKS

WATER DIVISION

Sketch of Service Here

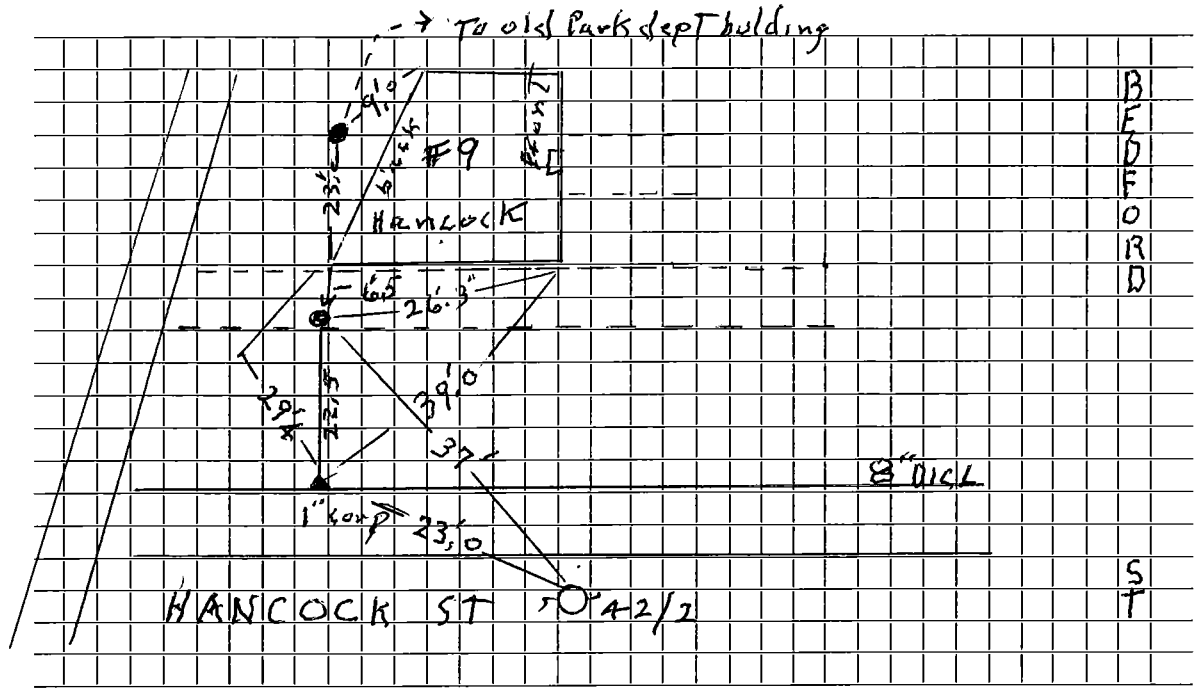

Connection made in Hancock St Street. Work completed 2012-De Felice

Remarks: curb in back of house Fed to service in house

.....
.....