

WATER SERVICE RECORD

Name

Service No.

Address 90A HANCOCK ST.

Location

Repair—Renewal—New Service


Date	Material	Amount	Total	Date	Amount
6-9-86	1" COPPER. 1" CURB W/BOX 25 LF 1" COPPER				
9/18/52	80' 1" COPPER 1 1"x1" S+LW 1 1"x3/4 Bush 1 1" Union				

DATE _____

TOWN OF LEXINGTON — BOARD OF PUBLIC WORKS

WATER DIVISION

Sketch of Service Here

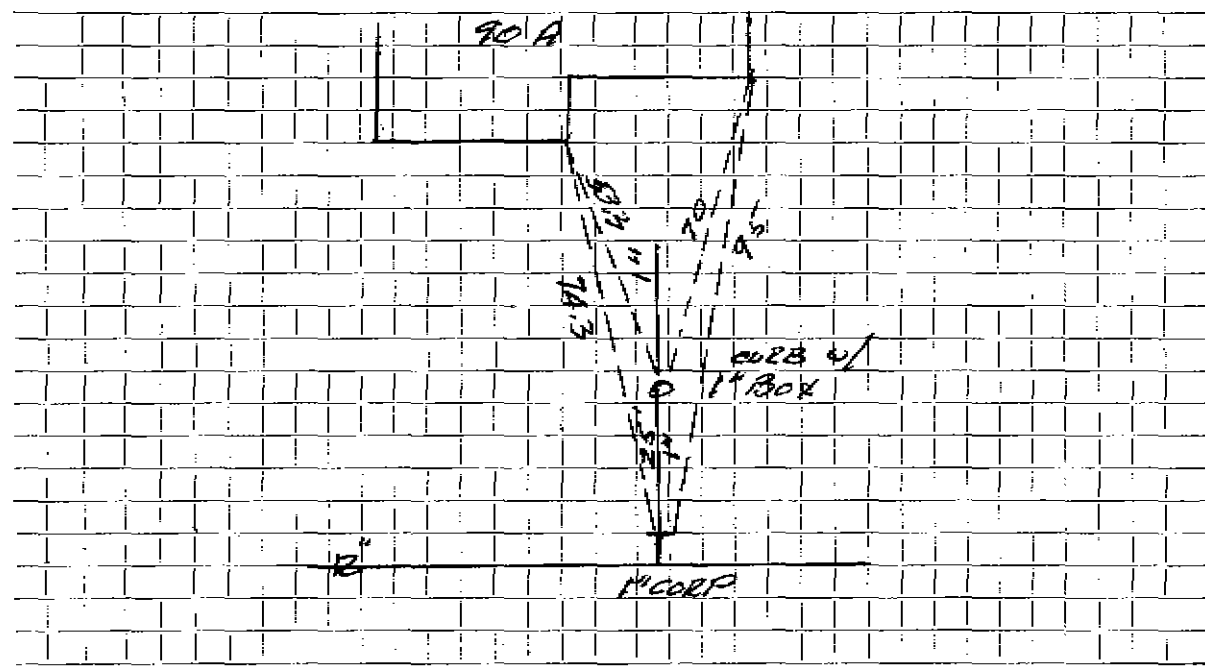

Connection made in HANCOCK ST Street. Work completed 6-9-86

Remarks: NEW 1\" SERV. TIED INTO EXST. 12\"
EXST. SERV. 1\"