

WATER SERVICE RECORD

Name

Service No.

Address 40 B HANGCOCK ST.

Location

Repair—Renewal—New Service


Date	Material	Amount	Total	Date	Amount
6-9-86	1-1" COPPER. 1-1" COPPER w/BOX 22.8 LF 1" COPPER				
5/17/48	IN 59' 1" COPPER 1 1" X 1" S+W 1 1" UNION 3 PART				

DATE 6-9-86

TOWN OF LEXINGTON — BOARD OF PUBLIC WORKS

WATER DIVISION

Sketch of Service Here

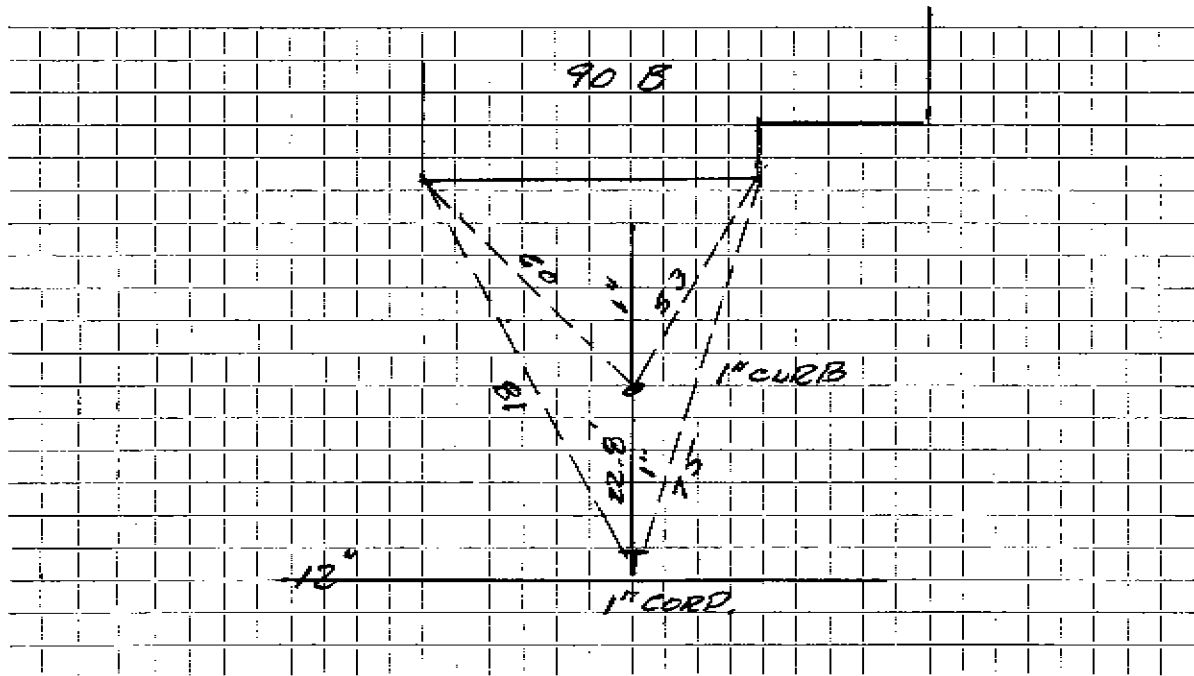

Connection made in HANCOCK Street. Work completed

Remarks: NEW 1" SERV. TIED INTO 12"
EXST. SERV. 1"