

WATER SERVICE RECORD

Name 91 HANCOCK ST.

Service No.

Address

Location


Repair—Renewal—New Service

Date	Material	Amount	Total	Date	Amount
6-10-86	3/4" COPPER. 3/4" CURB w/BOX 17.9 LF 3/4" COPPER				
7/21/48	7' 3/4 COPPER 1 3/4 x 1/2 S+W 1 3/4 Union				

DATE 6-10-86

TOWN OF LEXINGTON — BOARD OF PUBLIC WORKS
WATER DIVISION

Sketch of Service Here

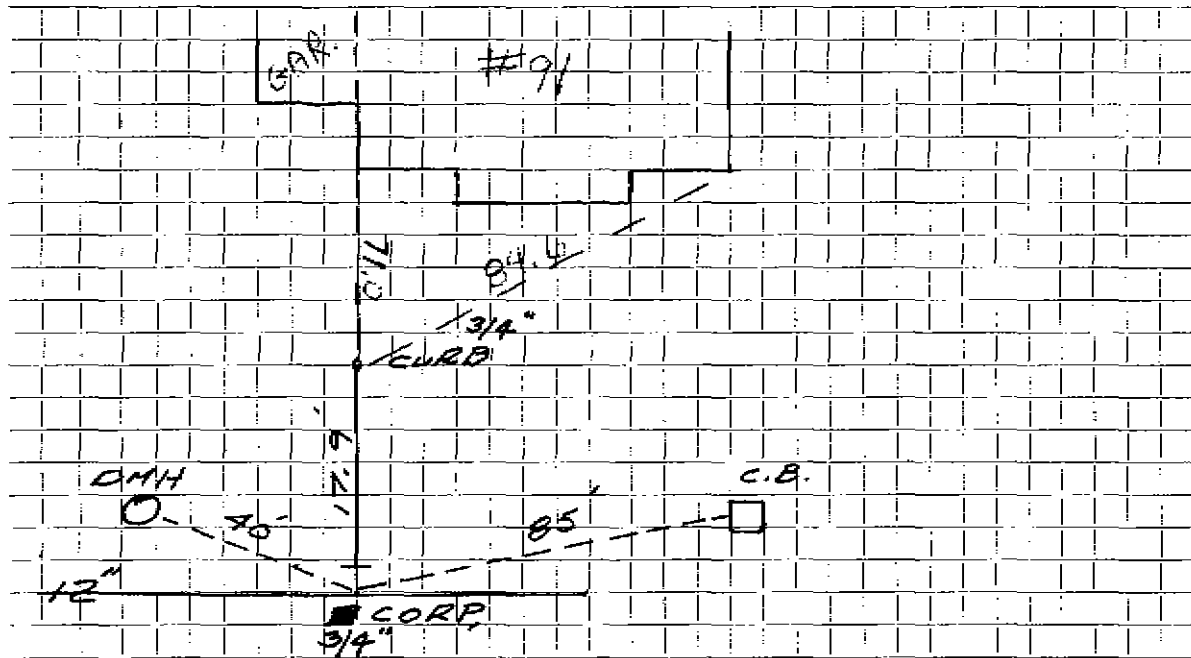

Connection made in HANCOCK Street. Work completed 6-10-86

Remarks: SERVICE CONNECTED TO 12" MAIN
EXST. SERV. 3/4" COPPER