

WATER SERVICE RECORD

Name Lexington Gardens

Service No. 181

Address 93 Hancock Street

Location

~~Repair~~ ~~Renewal~~ New Service

Comm. 12-1-58


Date	Material	Amount	Total	Date	Amount
10/2/58	Labor	34 71		8-29-58	75 00
	10% Overhead	3 47	38 18	12-1-58	83 34
	86'-2" Cement L Pipe @1.09		93 74		15 8 34
	1-2" Jenkins Valve		18 75		
					NON CHARGE
	2-2" Leadlined Elbows 90° @2.91	4 02	10/3/58	Labor	15 80
	2-2" x 6" Cement L Nipples @.79	1 58	32'-1" Copper Tubing @.5202		16 65
	1-2 x 1/4 Cement Lined Nipple		57	4-1" C Corp Cocks @7.06	28 24
	2 hrs. Trucking @.75		1 50	1-1"x1"x1"x2" 1/4 way Y	24 40
			\$158 34	1-2" Gate Valve	24 75
				1 Gate Box	15 95
				1 hr. Trucking @.75	75
					\$126 54

*Bill 12-1-58 23.34*

**TOWN OF LEXINGTON — BOARD OF PUBLIC WORKS**

**WATER DIVISION**

Sketch of Service Here

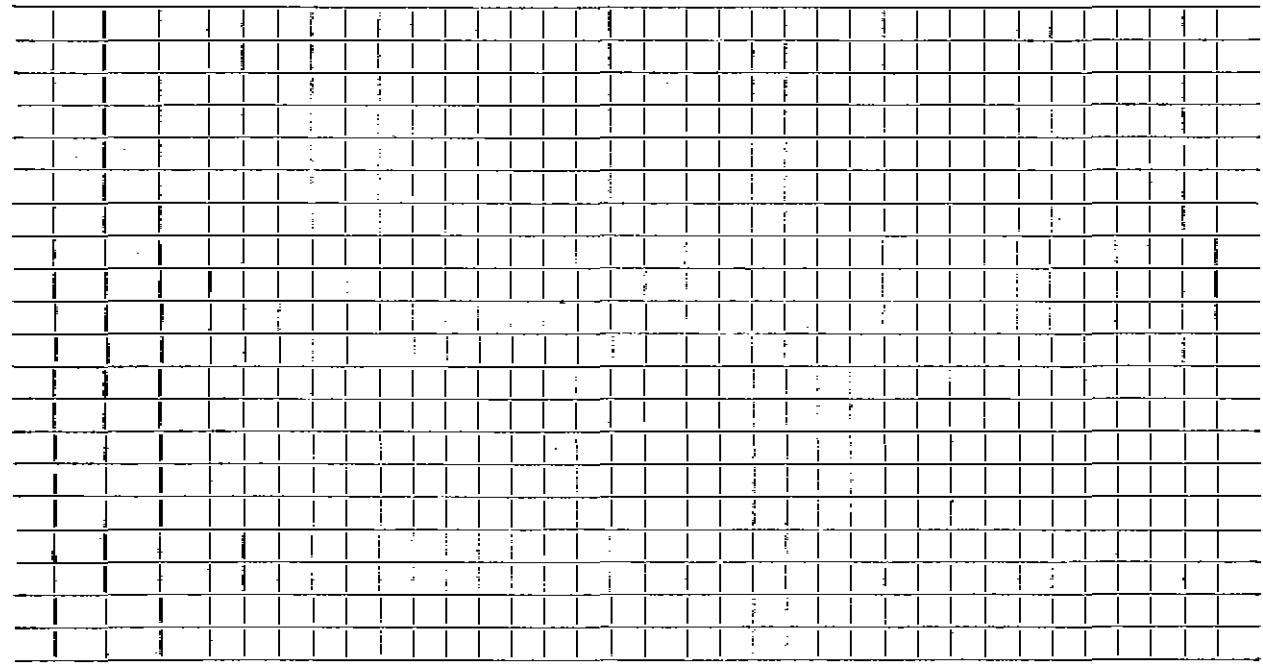

Connection made in ..... Street. Work completed .....

Remarks: .....  
.....  
.....