


DATE 6-10-86

TOWN OF LEXINGTON — BOARD OF PUBLIC WORKS
WATER DIVISION

Sketch of Service Here

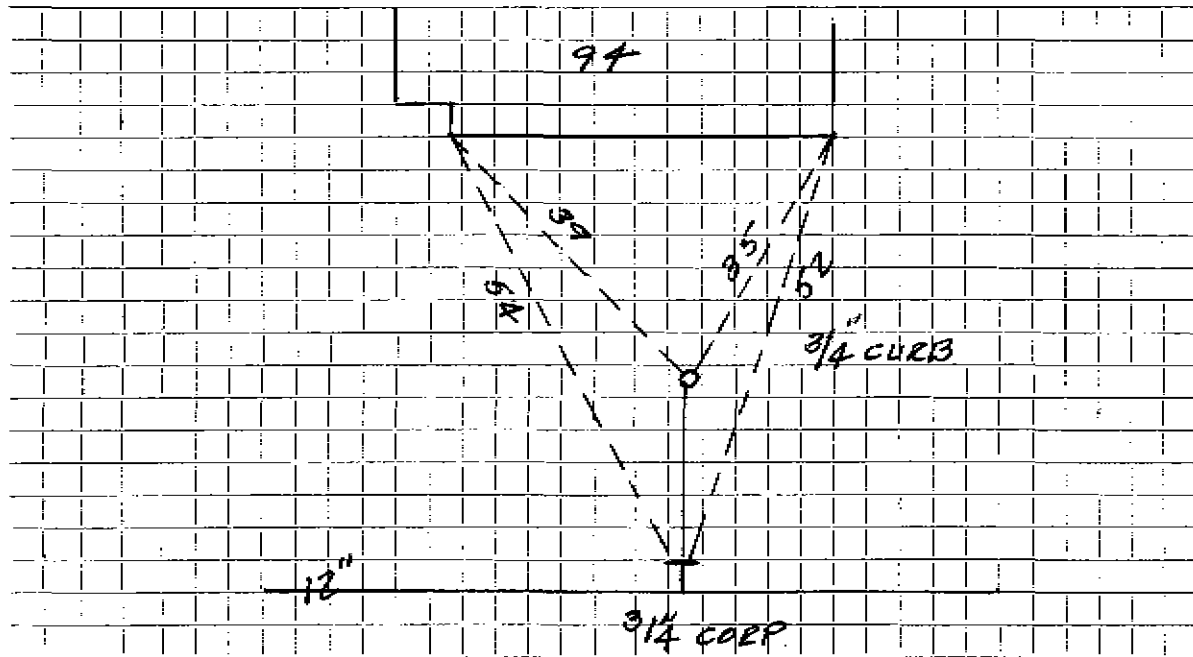

Connection made in HANCOCK Street. Work completed 6-10-86

Remarks: NEW 3/4\"
EXST. SERV. 3/4\" IRON