


DATE _____

TOWN OF LEXINGTON — BOARD OF PUBLIC WORKS

WATER DIVISION

Sketch of Service Here

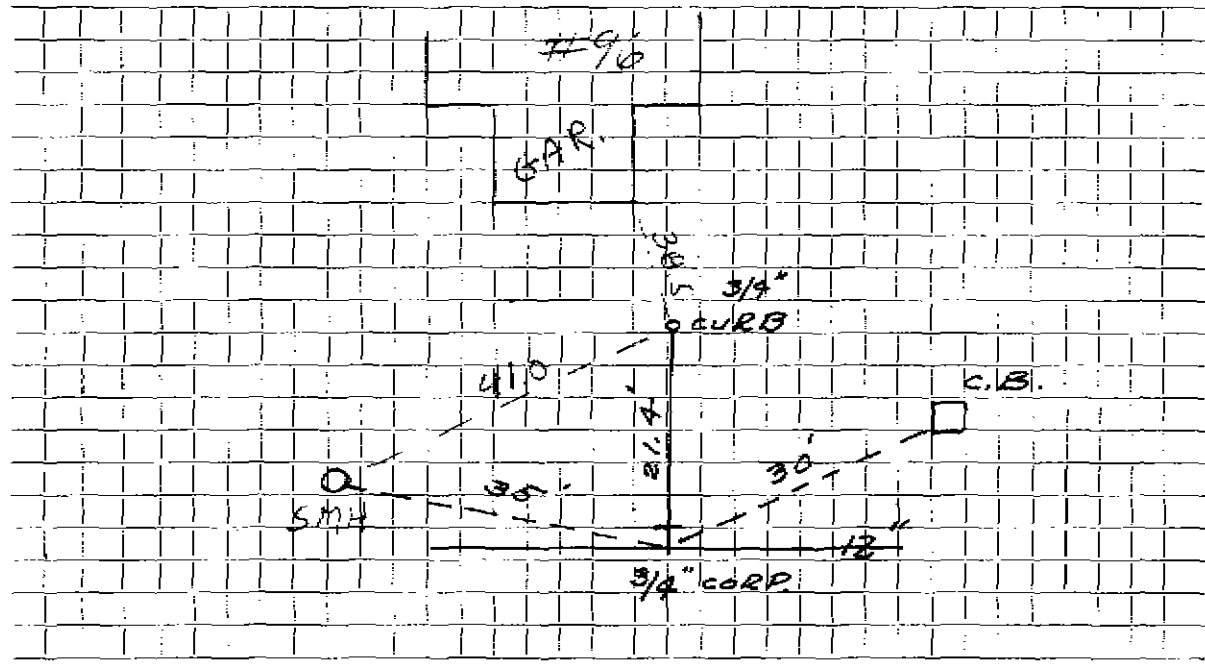

Connection made in HANCOCK Street. Work completed _____

Remarks: SERV. CONNECTED TO 12" MAIN
EXST. SERV. 3/4" COPPER