


DATE _____

TOWN OF LEXINGTON — BOARD OF PUBLIC WORKS

WATER DIVISION

Sketch of Service Here

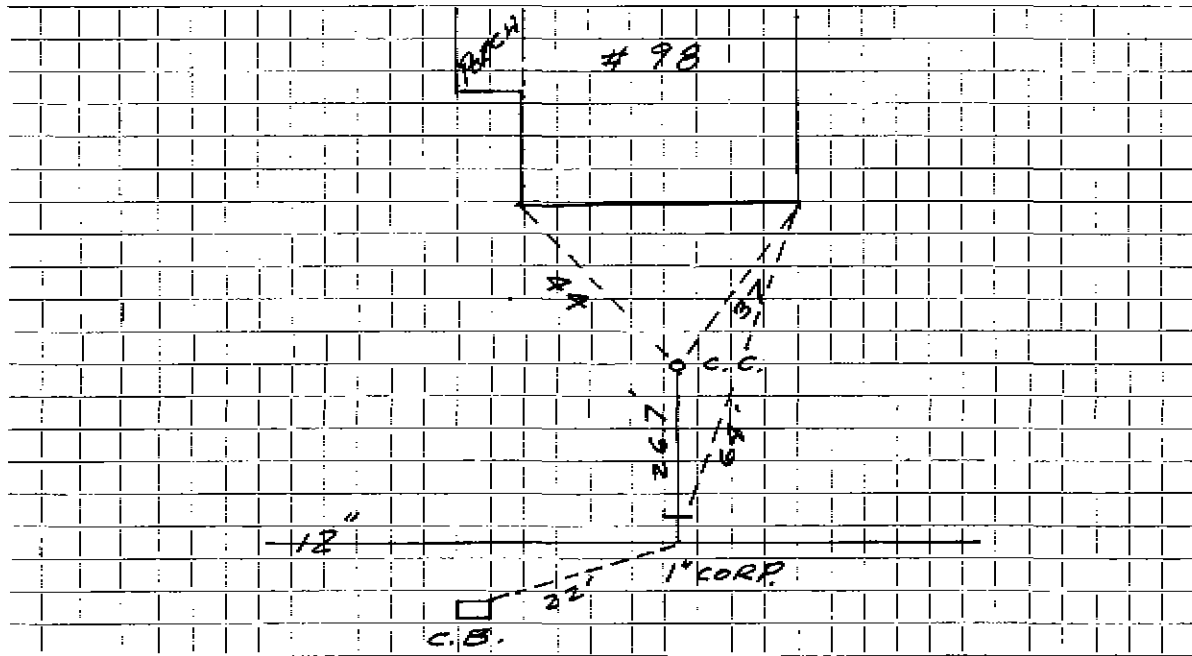

Connection made in HANCOCK Street. Work completed 6-11-86

Remarks: NEW SERVICE CONNECTED TO 12" MAIN
EXST. SERV. 1" IRON