


DATE _____

TOWN OF LEXINGTON — BOARD OF PUBLIC WORKS
WATER DIVISION

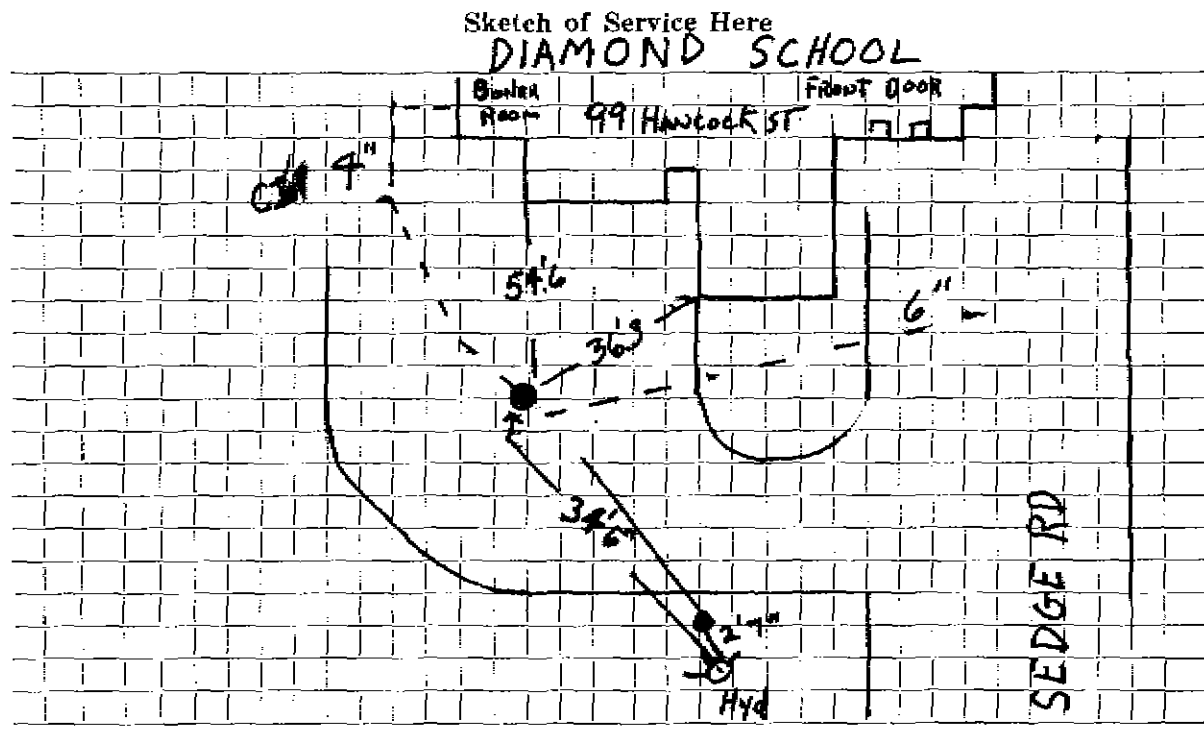

Connection made in Street. Work completed

Remarks: **GATE FOR Hyd UNDER PINE TREE ROOTS 5-29-90**