




DATE 01/03/24

TOWN OF LEXINGTON — BOARD OF PUBLIC WORKS

WATER DIVISION

Sketch of Service Here

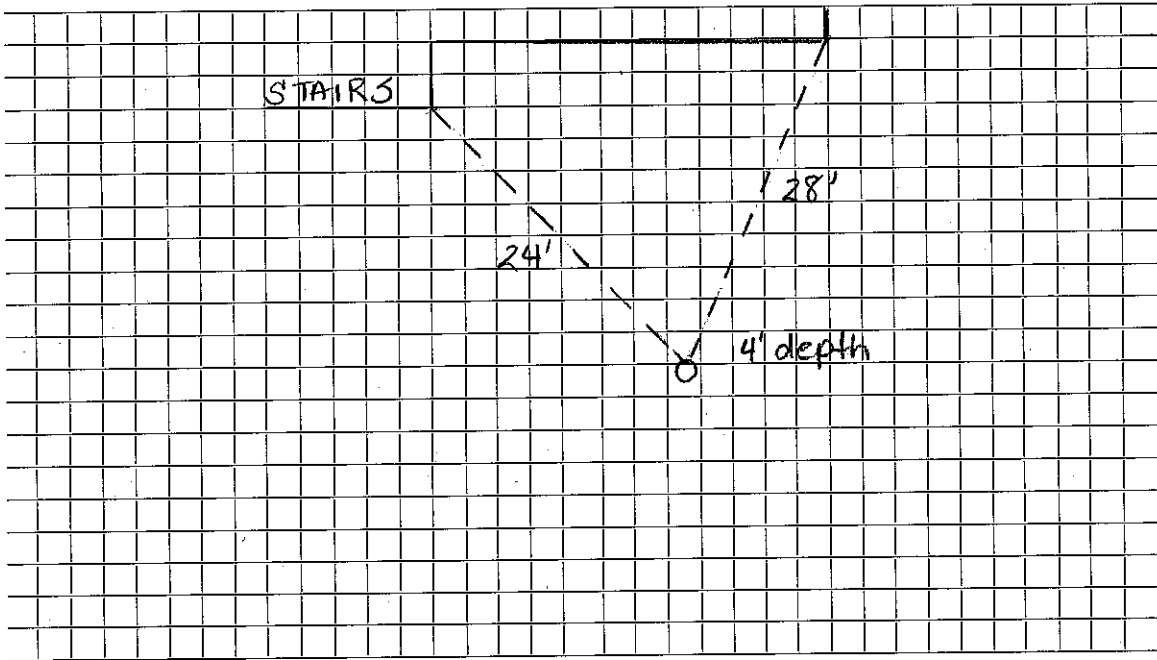

Connection made in Harbell Street Street. Work completed .....

Remarks: Installed by Mendez Construction .....