

WATER SERVICE RECORD

3575

Name William H. Hamilton

Service No. 88

Address 10 Harbell Street, Lexington 73, Massachusetts

7492

Location

~~Water~~ New Service


Com. 11-17-58

Date	Material	Amount	Total	Date	Amount
5/16/58	Labor	11 75		5-14-58	Deposit 75 00
	10% Overhead	1 18	12 93	11-17-58	Refund 36 56
	45' 3/4" Copper Tubing @ 37		1665		38 44
	1 3/4" C x 1/2 I.W.H. S.& W.		5 84		NON CHARGE
	1 3/4" C3Part Union		2 27	5/16/58	Labor 5 23
	1 Hour Trucking @ 75		75	20' 3/4" Copper Tubing @ 37	7 40
			38 44	1 3/4" C Corp Cock	4 64
				1 3/4" C Curb Cock	6 03
				1 Box & Rod	5 00
				1 1/2 Straight Tail Piece	50
				1 1/2 Off Set Tail Piece	50
					29 30

DATE _____

TOWN OF LEXINGTON — BOARD OF PUBLIC WORKS
WATER DIVISION

Sketch of Service Here

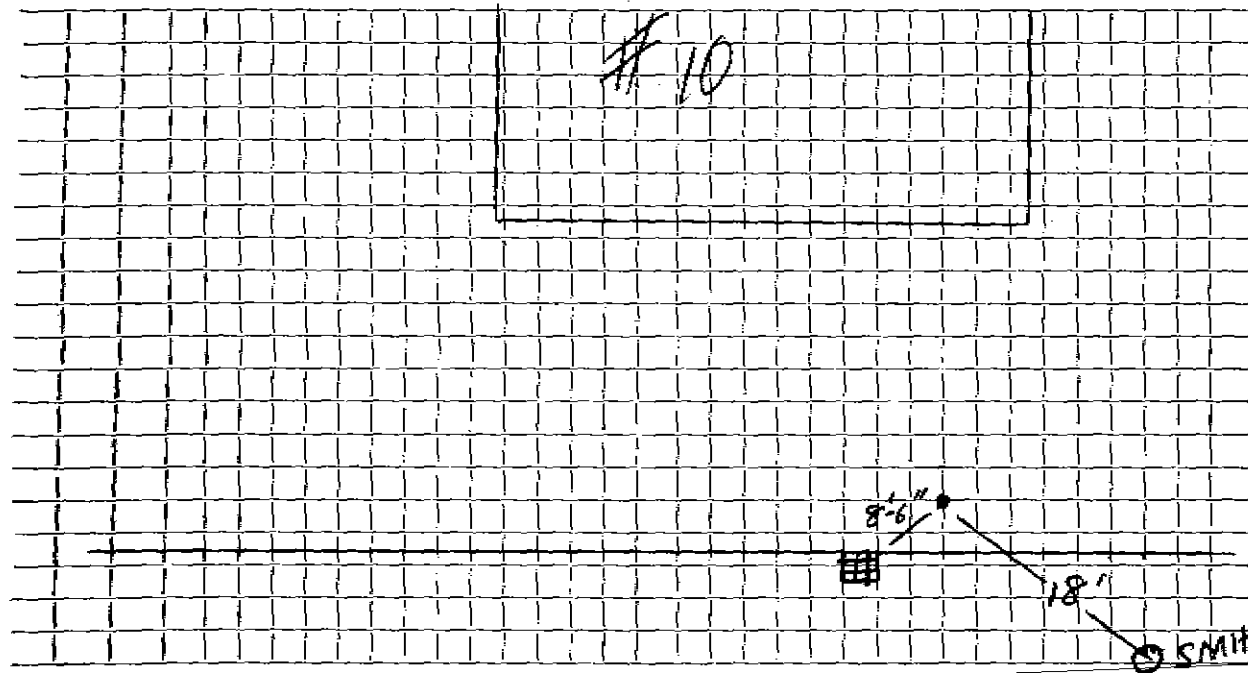

Connection made in Street. Work completed

Remarks:
.....
.....