

WATER SERVICE RECORD

#4371

Name Richard Hamilton

Service No. 199

Address 14 Harbell Street

Location

~~REPAIR~~ - Renewal - ~~NEW SERVICE~~


Comm 11-16-59

Date	Material	Amount	Total	Date		Amount
9-10-59	Labor	37.12		8-28-59	Deposit	150.00
	10% O.H.	3.71	40.83	11-16-59	Retard	85.42
	26' 3/4" Copper tubing@.41		10.66			64.58
	1 3/4" Cx 1/2 I.W.H. Stop&Waste		5.84			
	1 Hr. Trucking@.75		.75		NON CHARGE	
	1 Hr. Town Shovel@6.50		6.50		Labor	7.40
			64.58	22'	3/4" Copper tubing@.41	9.02
				1	3/4" C Curb Cock	5.98
				1	3/4" Corp Adapter	4.67
				1	1/2 Straight tailpiece	.50
				1	1/2 Offset tailpiece	.50
						28.65

TOWN OF LEXINGTON — BOARD OF PUBLIC WORKS

WATER DIVISION

Sketch of Service Here

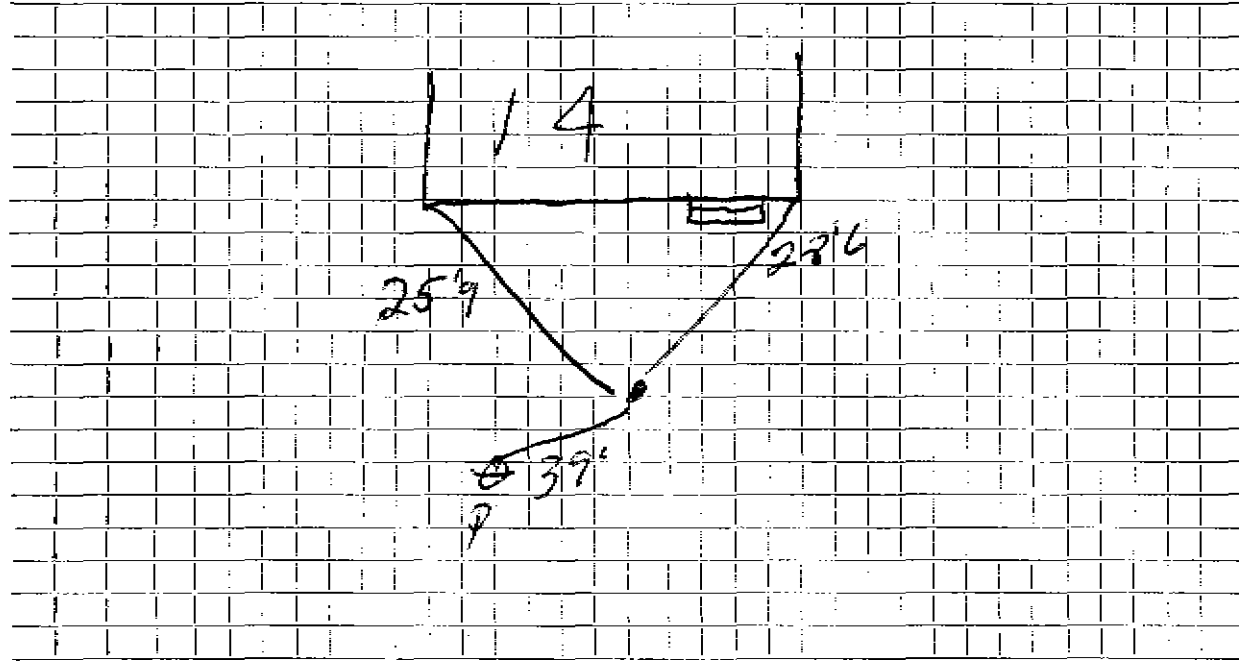

Connection made in Street. Work completed

Remarks:
.....
.....