

## WATER SERVICE RECORD

# 4915

Name William Hamilton

Service No. 256

Address 18 Harvell Avenue

Location Harbell Street

~~Repair - Renewal - New Service~~

Comm. 12/31/57


Date	Material	Amount	Total	Date	Amount
11/6/57	Labor	3 90		11-1-57	Deposit \$ 35 00
	10% overhead	39	4 29	12-31-57	Refund 9 78
	35' - 3/4" Copper tubing @ .37		12 95		25 22
	1 - 3/4" Cx 1/2 I.W.H. Stop & Waste		4 96		NON CHARGE
	1 hr. Trucking		75		Labor 3 52
	1 - 3/4" C Union (3 part)		2 27		30' - 3/4" Copper tubing @ .37
			25 22		11 10
					1 - 3/4" C. Corp Cock 4 64
					1 - 3/4" C. Curb Cock 5 94
					1 Box & Rod 4 62
					1 - 1/2 Straight tailpiece 50
					1 - 1/2 Offset tailpiece 50
					30 82

DATE

TOWN OF LEXINGTON — BOARD OF PUBLIC WORKS

**WATER DIVISION**

Sketch of Service Here

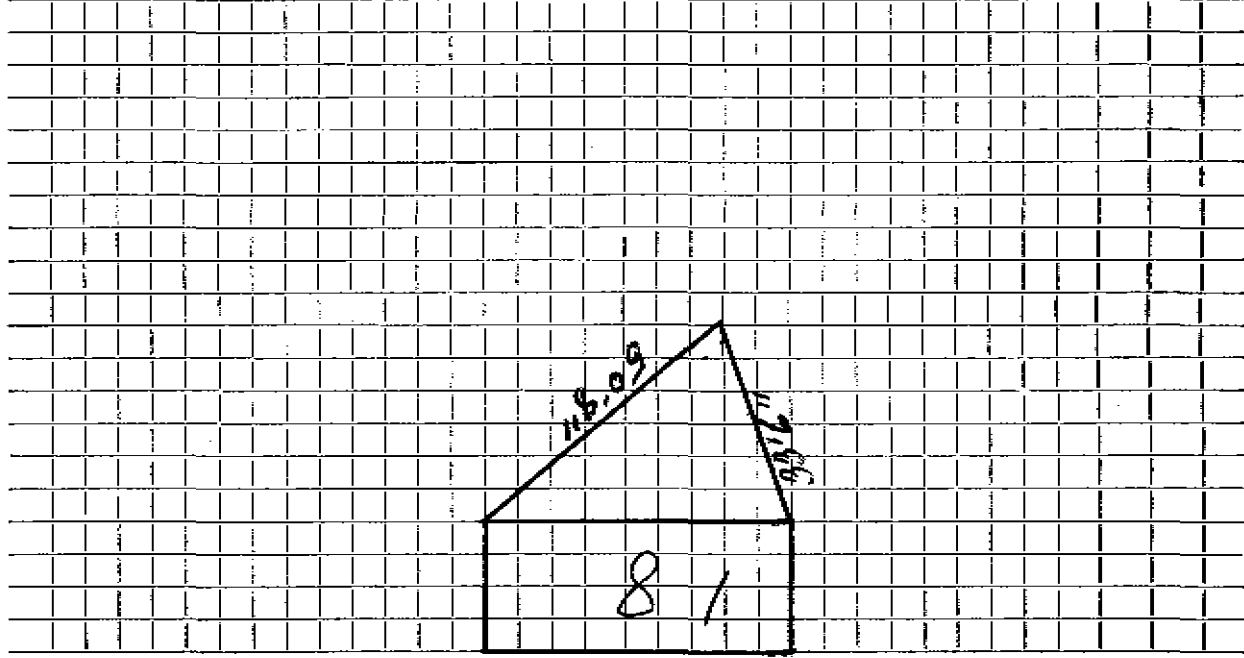

Connection made in *L.B. Merrill* Street. Work completed

Remarks: