

#5364
6767

WATER SERVICE RECORD

Name Donna Realty Trust

Service No. 90

Address 21 Harbell Street

Location

~~REPAIR WORK~~ - New Service W.O. #903 T.D. Sullivan Permit #473

MAR 14 1966


Date	Material	Amount	Total	Date	Amount
9-14-65	Labor	41. 42		8-30-65	100 00
	10% O.H.	4 14	45 56	3-14-66	11 47
10'	3/4" copper tubing @ .42		4 20		88 33
1	Curb		8 76		
1	Corp.		7 41		
1	Box & Rod		4 90		
	8 x 3 Patch		8 00		
1	Hr. Town Truck		3 00		
1	Hr. Town Shovel		6 50		
			88 33		
9-15-65	41' 3/4" copper tubing				

DATE _____

TOWN OF LEXINGTON — BOARD OF PUBLIC WORKS

WATER DIVISION

Sketch of Service Here

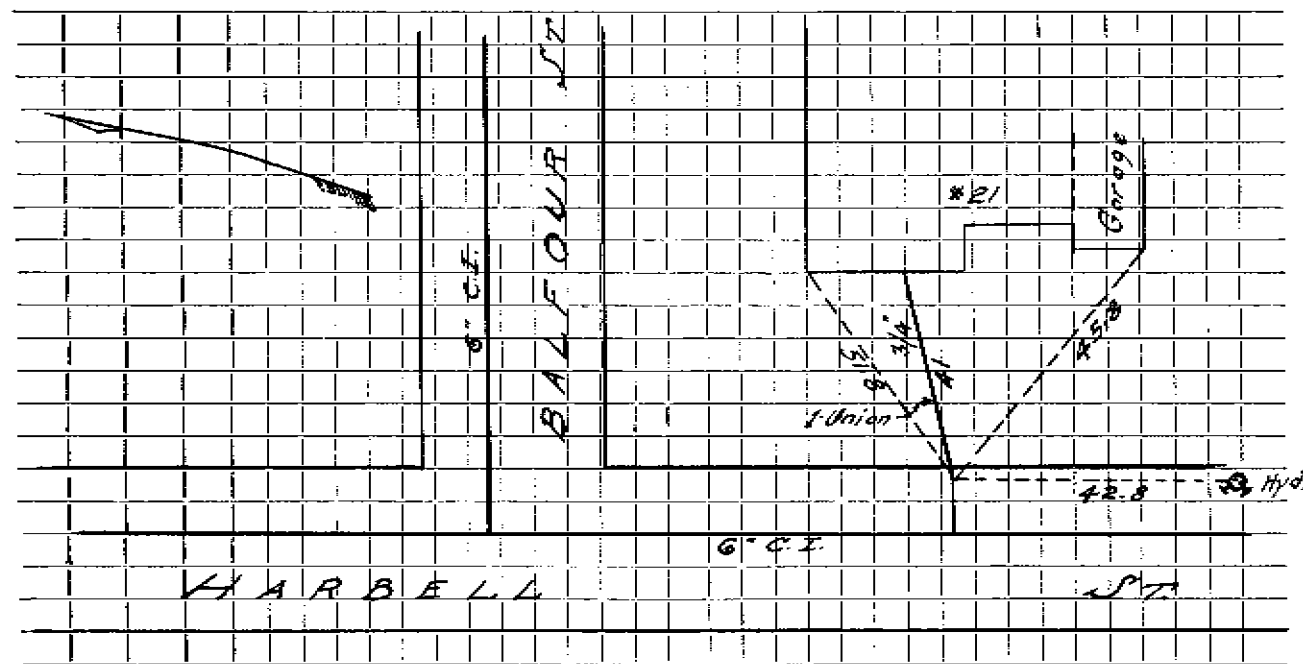

Connection made in Street. Work completed

Remarks:
.....
.....