

## WATER SERVICE RECORD

Name William H. Hamilton

Service No. 213

Address 22 Harbell Ave.

Location

~~Repair~~ ~~Renewal~~ — New Service

Comm. 12-9-57


Date	Material	Amount	Total	Date	Amount	
9/30/57	labor	2 15		9-26-57	Deposit	35 00
	10% overhead	22		12-2-57	Refund	12 67
			2 37		NON CHARGE	\$ 22 33
	38' 3/4" copper tubing @ .375	14 25			labor	1 53
	1 3/4" Cx 1/2 IWH stop & waste	4 96		24'	3/4" copper tubing @ .375	9 00
	1 hr. trucking @ .75	75			1 3/4" C corp cock	4 64
			22 33		1 3/4" C curb cock	5 94
					1 box & rod	4 62
					1 1/2 straight tail pc.	50
					1 1/2 offset tail pc.	50
						26 73

TOWN OF LEXINGTON — BOARD OF PUBLIC WORKS

WATER DIVISION

DATE

Sketch of Service Here

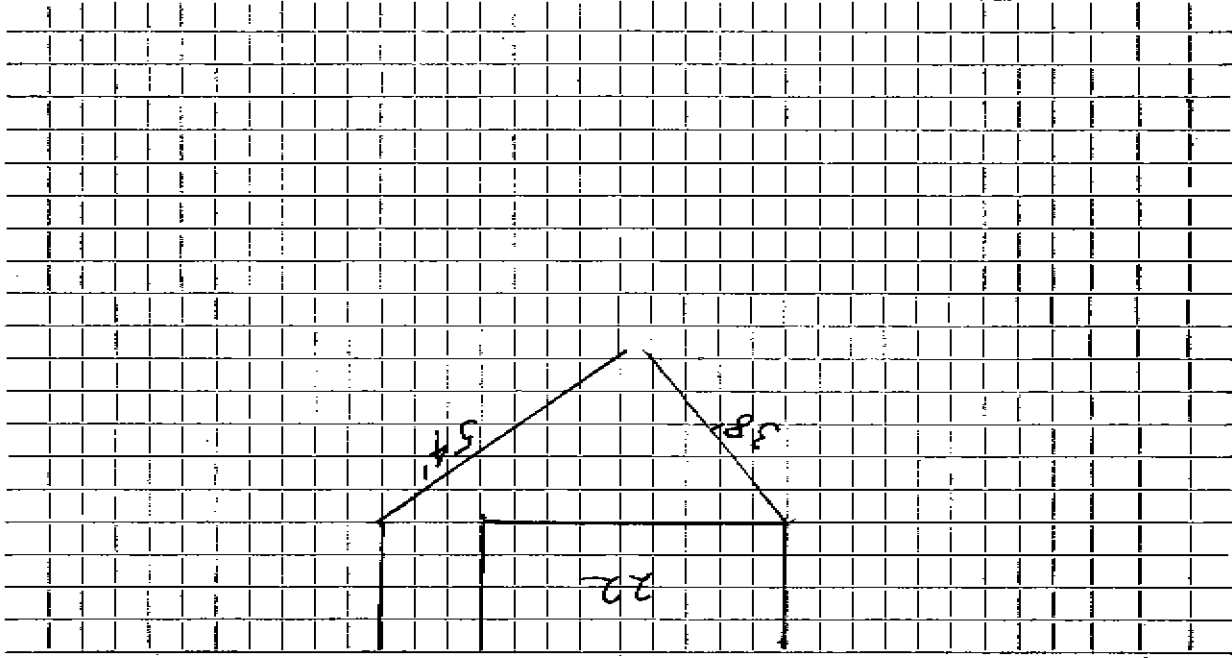

Connection made in

Street.

Work completed

Remarks: