

WATER SERVICE RECORD

#6152 6334 #4306

Name William Hamilton

Service No. 257

Address 24 Harbell Street

#5960

Location


~~Repair~~ ~~Renewal~~ - New Service

Comm. 12/31/57

Date	Material	Amount	Total	Date	Amount	
11/6/57	labor	3 90		11-1-57	Deposit	\$ 35 20
	10% overhead	39		12-31-57	Refund	9 78
			4 29			\$ 25 22
	35' 3/4" copper tubing @ .37	12 95			Non Charge	
	1 3/4" x 1/2 IWH stop & waste	4 96			labor	3 52
	1 hr. trucking @ .75	75			30' 3/4" copper tubing @ .37	
	1 3/4" C 3 part union	2 27				11 10
			25 22		1 3/4" C corp cock	4 64
					1 3/4" C curb cock	5 94
					1 box & rod	4 62
					1 1/2 straight tail pc.	50
					1 1/2 offset tail pc.	50
						30 82

TOWN OF LEXINGTON — BOARD OF PUBLIC WORKS
WATER DIVISION

Sketch of Service Here

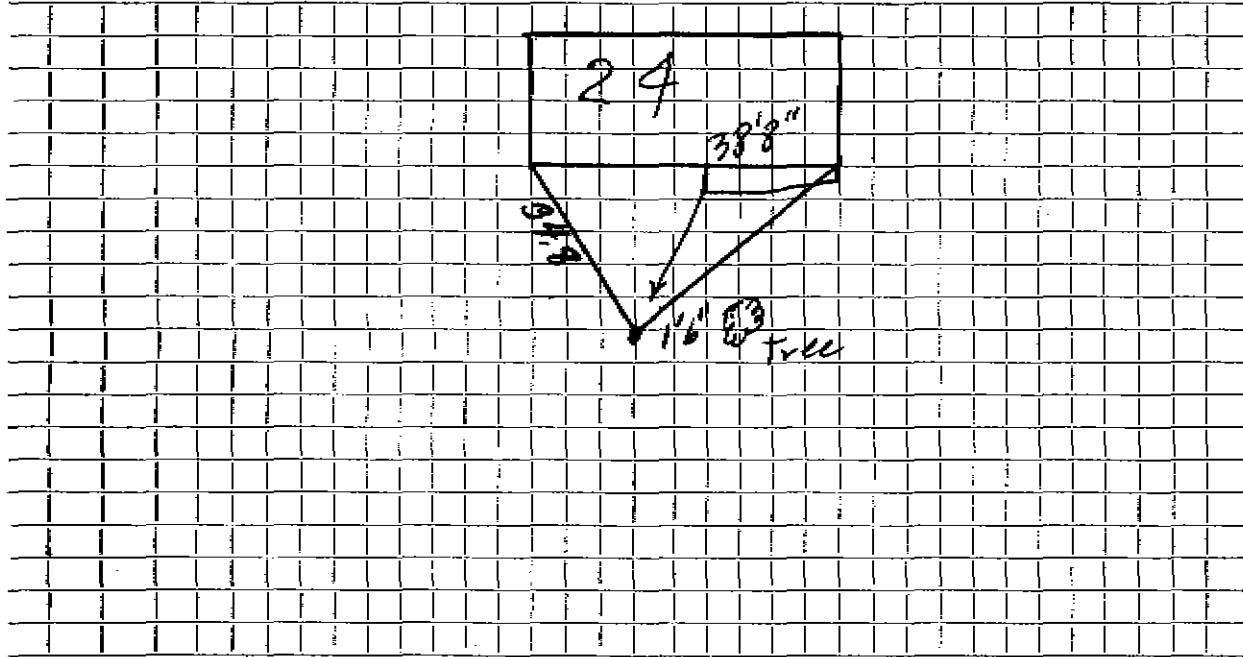

Connection made in 24 Harbor Street. Work completed

Remarks:

.....

.....